

**MONTGOMERY**  
**E 2**  
**8-1-70**

MISSISSIPPI  
 BOARD OF WATER COMMISSIONERS  
 416 North State Street  
 Jackson, Mississippi 39201

**CODED**

**WATER WELL DRILLERS LOG**

**8-1** 19**70** Smith Well Drilling Montgomery  
 date well completed firm name county well located

LANDOWNER: Charley Parnell  
R1 Box 169  
Shuck Hill Miss  
 (mailing address)

WELL LOCATION:  
 sec. 24 T 20 N R. 7 E  
3 miles S of ALVIN  
 (distance) (direction) (nearest town)

WELL PURPOSE: Home  
 (home, irrigation, municipal, industrial)

- WELL COMPLETION DATA:
- (1) diameter (inches) 2"
  - (2) total depth (feet) 380
  - (3) static water level (feet) 170 below above top of ground.
  - (4) casing 2" Galv, 273,  
 (material) (depth)  
 (size) if telescope see back.
  - (5) screen no,  
 (length) (depth to top)  
X, A  
 (size) (material)
  - (6) pump 3/4 hp Wood Comp Pump, 250  
 (HP) (yield gph) PH
  - Electricity  
 (type power)
  - (7) electric log NO  
 (yes or no)
  - (organization running log)
  - (8) how well bottom plugged

description of formations encountered	from	to
Red clay	0	16
Red sand Rock mix	16	28
gray sand	28	65
gray Rock	65	66
Gray sand	66	79
Rock	79	81
gray sand white clay mix	81	94
Rock	94	95
Blue clay	95	98
gray sand charcoal mix	98	110
Rock		
gray clay	110	118
Rock	118	122
gray sand	122	130
Blue clay	130	148
Rock		
Blue clay	148	156
Black sand	156	166
Blue clay	166	170
gray sand	170	276
Black clay	276	280
gray clay	280	293
gray clay Black sand mix	293	350
fine Blue sand	350	358
Blue clay	358	365
Shell Rocks	365	370
Blue sand	370	380

**CODED**

SEP 29 1970


DRILLERS REMARKS: open well  
Very well

If well telescopes please sketch and show depths.

GROUND LEVEL

273 ft 2"

open no screen

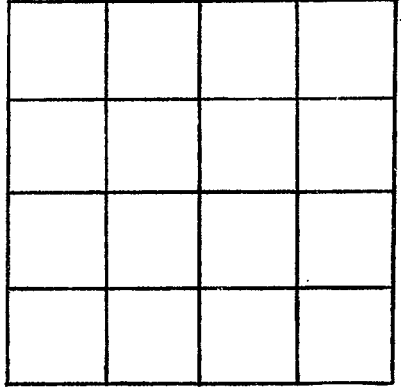

SECTION \_\_\_\_\_

Please indicate well location X.

ADDITIONAL INFORMATION

Multiple horizontal lines for providing additional information.

If more than one screen, show locations of each on sketch.