

Montgomery
E 3
3-22-72

MISSISSIPPI
BOARD OF WATER COMMISSIONERS
416 North State Street
Jackson, Mississippi 39201

WATER WELL DRILLERS LOG

CODED

3-22 1972
date well completed

Thomas & Son
firm name

Montgomery
county well located

LANDOWNER: Felix TREVAN

Duckhill Miss.

(mailing address)

WELL LOCATION:

sec. 1 T 20N R 7 E
1/2 miles S of ALVA
(distance) (direction) (nearest town)

WELL PURPOSE:

(home, irrigation, municipal, industrial)

WELL COMPLETION DATA:

- (1) diameter (inches) 2
- (2) total depth (feet) 180
- (3) static water level (feet) 65 ^{below} _{above} top of ground.
- (4) casing PVC 170
(material) (depth)
2
(size) if telescope see back.
- (5) screen 10 170
(length) (depth to top)
2" 8 slot PVC
(size) (material)
- (6) pump 1 7
(HP) (yield gpm)
elec.
(type power)
- (7) electric log no
(yes or no)

(organization running log)

(8) how well bottom plugged joint

description of formations encountered

from to

Red Sand	0	18
Sand Rocks	18	25
Chalk & sand streak	25	50
Grey Chalk & fine sand	50	91
shells thin rock	91	93
hard grey chalk	93	168
Coarse Brownish SAND	168	180

CODED


APR 5 1972

MISS. BD. OF
WATER COM.

DRILLERS REMARKS:

If well telescopes please sketch and show depths.

GROUND LEVEL

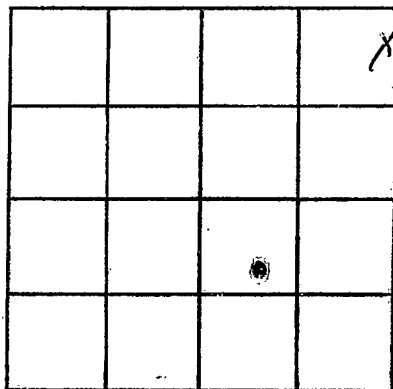

SECTION /

Please indicate well location X.

ADDITIONAL INFORMATION

If more than one screen,
show locations of each on sketch.