

MONTGOMERY

E5

2-1-83

Elog #43

February 1983
date well completed

MISSISSIPPI
BOARD OF WATER COMMISSIONERS
416 North State Street
Jackson, Mississippi 39201

CODED

WATER WELL DRILLERS LOG

Robert E. Ratliff Co., Inc. Montgomery
firm name county well located

LANDOWNER: Hays Creek

Water Association

P.O. Box 613

Winona, Ms. 38967
(mailing address)

WELL LOCATION:

on 19 sec 36 T 20 N R 7 E

Lodi Community
of (distance) (direction) (nearest town)

WELL PURPOSE: municipal
(home, irrigation, municipal, industrial)

WELL COMPLETION DATA:

(1) diameter (inches) 12 x 6

(2) total depth (feet) 446'

(3) static water level (feet) 109' below
top of ground.

(4) casing steel, 406'
(material) (depth)

12"
(size) if telescope see back.

(5) screen 40', 406'
(length) (depth to top)

6", stainless steel
(size) (material)

(6) pump 40, 200
(HP) (yield gpm)

electric
(type power)

(7) electric log yes
(yes or no)

MG S - state
(organization running log)

(8) how well bottom plugged BPV

description of formations
encountered

from to

Top soil

0 27

Clay

27 55

Sand

55 116

Sand & Clay

116 207

Sand

207 299

Sand & Clay

299 330

Clay

330 360

Sand

360 452

Clay

452 635

Sand

635 696

Clay

696 727

Sand

727 757

Clay

757 849

CODED

DEPT. OF NATURAL RESOURCES
BUREAU OF LAND & WATER RESOURCES

APR - 4 1983


RECEIVED

DRILLERS REMARKS:

8

If well telescopes please sketch and show depths.

GROUND LEVEL

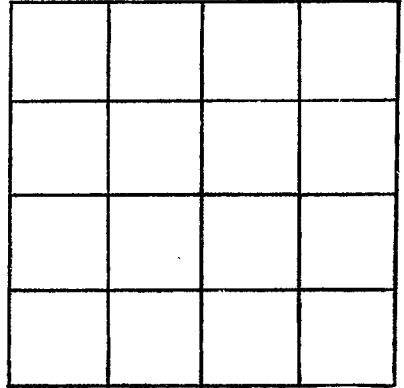

SECTION _____

Please indicate well location X.

ADDITIONAL INFORMATION

If more than one screen, show locations of each on sketch.