

CODED

F 7
10-17-63

WATER WELL DRILLERS LOG

Date: 10-17, 1967, Driller: Thomas & Son County Montgomery
(Name)

(1) Owner of Land: Mr. Kirk Caffey
(Name)
Winona, Miss.
(Address)

(2) Location: SE 1/4, SE 1/4, Sec. 11 T19R5
3 miles N, of Winona
(distance) (direction) (Nearest Town)

(3) Topography: (Hilly) (Flat) (Level)

(4) Purpose of Well: (Domestic Irrigation)
(Municipal, Industrial, Other)

| Description & Color of Materials Sand, Clay, Red Clay, Shell, etc. | Thick- ness Feet | Depth Feet |
|---|------------------------|---------------|
| <u>Chalk</u> | <u>15</u> | <u>0</u> |
| <u>White Chalk w/ Sand</u> | <u>65</u> | <u>15</u> |
| <u>Black Dirt-Little Sand</u> | <u>45</u> | <u>80</u> |
| <u>Coarse Blue Sand</u> | <u>13</u> | <u>12.5</u> |

Information upon completion of well:

(1) Diameter 2 inches.

(2) Total Depth 138 feet.

(3) Water Level 75 feet below top of ground.


(4) Cased to 132, Size 2"

(5) Screen: Size 8 slot, Length 6 ft.

(6) Were any formations sealed against pollution?
yes, no

CODED

If YES depth of formation _____
Why _____
Drillers Remarks: _____

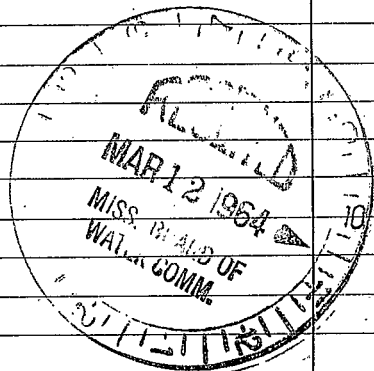

(Use Back Side)

Well No.

