

CODED 3

WATER WELL DRILLERS LOG

F 8
1-30-64

Date: 1-30, 1964, Driller: Smith L. Prady, County: Montgomery
(Name)


(1) Owner of Land: Mrs. Shadon Smith
(Name)
Winona Miss
(Address)
(2) Location: SE 1/4 SE 1/4, Sec. 11 T17 R5 E8
1 1/2 miles North of Winona,
(distance) (direction) (Nearest Town)
(3) Topography: Hilly
(Hilly) (Flat) (Level)
(4) Purpose of Well: Domestic
(Domestic Irrigation
Municipal, Industrial, Other)

Description & Color of Materials Sand, Clay, Red Clay, Shell, etc.	Thick- ness Feet	Depth Feet
Yellow Clay	30	30
Black Clay	17	47
hard shale	1	48
yellow sand		
Clay mixture	20	68
green sand	14	82
hard rock	1	83
sand and a light clay mixture	7	88
a good grad of gray sand	10	98
Rock	6"	
black clay	2.0	118
hard shale		
a series of thin rock	8	126
black clay	40	166
shale sandy mixture	10	176
a very good grade of white coarse sand	13	189

Information upon completion of well:

(1) Diameter 2 inches.
(2) Total Depth 189 feet.
(3) Water Level 110 feet below top of ground.
(4) Cased to 186, Size _____
(5) Screen: Size 1/4", Length 6'
(6) Were any formations sealed against pollution?
yes, NO no.

If YES depth of formation _____
Why _____
Drillers Remarks: _____

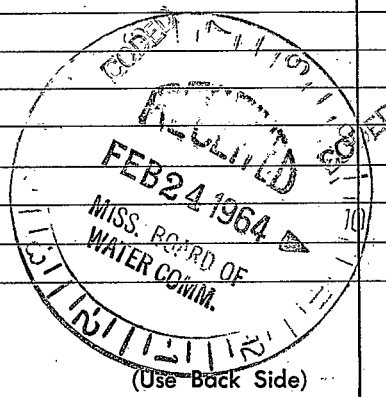

50
570

