

F9  
1-15-64

WATER WELL DRILLERS LOG

*Cont locate*  
**CODED**

Date: JAN. 15, 1964, Drillers: DELTA DRILLING Co. County MONTGOMERY  
(Name)

(1) Owner of Land: CECIL BARNETT  
(Name)

WINONA, MISS.  
(Address)

(2) Location: 1/4, 1/4, Sec. 14 19 5

           miles            of             
(distance) (direction) (Nearest Town)

(3) Topography:             
(Hilly) (Flat) (Level)

(4) Purpose of Well: DOMESTIC  
(Domestic Irrigation  
Municipal, Industrial, Other)

Description & Color of Materials Sand, Clay, Red Clay, Shell, etc.	Thick- ness Feet	Depth Feet
CLAY	24	24'
SHALE	108	132'
GREEN SAND	86	218'
CLAY	81	299'
GREEN SAND	42	341'
GUMBO	38	379'
WHITE SAND	31	410'

Information upon completion of well:

(1) Diameter 4 inches.

(2) Total Depth 410 feet.

(3) Water Level 149 feet below top of ground.  
275' - 4"

(4) Cased to 400', Size 125' - 2"

(5) Screen: Size 2", Length 10'

(6) Were any formations sealed against pollution?


           yes,            no.

If YES depth of formation           

Why           

Drillers Remarks: 1 1/2 H.P. SUBMERSIBLE  
RED JACKET PUMP SET 189'  
IN WELL W/1 1/4" PIPE -

*2 60*  
*8 11 0*  
**CODED**

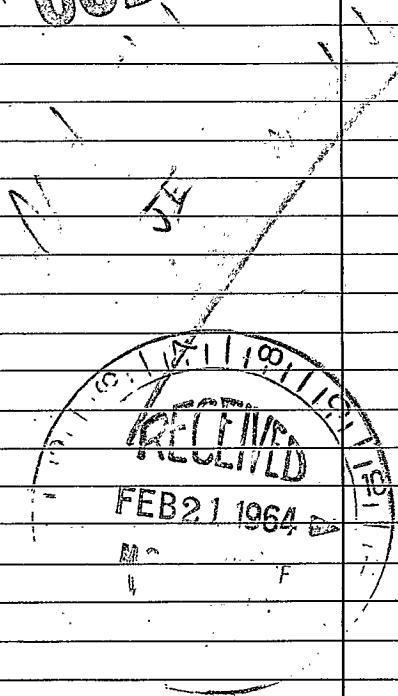

(Use Back Side)

Well No.

