

F 10

WATER WELL DRILLERS LOG

CODED

not located

4-20-64

Date: April 20, 1964, Driller: Robert E. Ratliff County Grenada

(Name)

(1) Owner of Land: Dejaco, Inc.
(Name)
Winona, Miss
(Address)

(2) Location: 1/4, 1/4, Sec. 27 19 R 5
_____ miles _____ of _____
(distance) (direction) (Nearest Town)

(3) Topography: Hilly
(Hilly) (Flat) (Level)

(4) Purpose of Well: Domestic
(Domestic Irrigation
Municipal, Industrial, Other)

Description & Color of Materials Sand, Clay, Red Clay, Shell, etc.	Thick- ness Feet	Depth Feet
Top Soil	0	10
Sandy Formations	10	100
Sand & Gravel	100	150
Sandy clay	150	250
Rock & clay	250	300
Green sand	300	375
clay	375	400
sandy clay	400	490
clay	490	510
Course sand	510	552

Information upon completion of well:

(1) Diameter 4 1/2 inches.

(2) Total Depth 552 feet.

(3) Water Level 175 feet below top of ground.

(4) Cased to 552, Size 4"

(5) Screen: Size 2", Length 10'


(6) Were any formations sealed against pollution?
X yes, _____ no.

CODED

If YES depth of formation Cased

Why _____

Drillers Remarks: _____

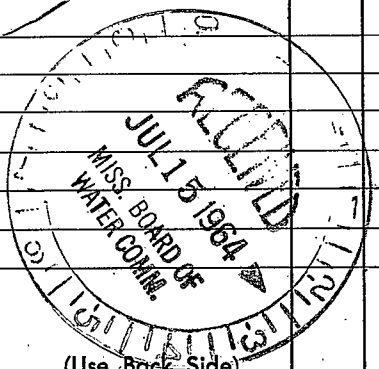

Well No.

