

F 22

WATER WELL DRILLERS LOG

F 22

2-11-61

MONTGOMERY

Date: 2-11, 1961, Driller: DELTA DRILLING Co. County: LEFLORE

(Name)

(1) Owner of Land: C. H. GEORGE (Name) WINONA, MISS (Address)

(2) Location: 1/4, 1/4, Sec. 21 T19N R5E miles (distance), of (direction), (Nearest Town)

(3) Topography: (Hilly) (Flat) (Level)

(4) Purpose of Well: DOMESTIC (Domestic Irrigation, Municipal, Industrial, Other)

Description & Color of Materials Sand, Clay, Red Clay, Shell, etc.	Thick- ness Feet	Depth Feet
CLAY	18	1.8
SAND	63	81
CLAY	47	128
GREEN SAND	63	191
CLAY W/ SAND STREAKS - 10" ROCK	65	246
HARD CLAY	41	287
SAND	27	314
SHELL	41	355
SHELL STREAKED SAND	42	397
WHITE SAND	48	445

Information upon completion of well:

(1) Diameter 4 inches.

(2) Total Depth 445 feet.

(3) Water Level 212 feet below top of ground.

(4) Cased to 445, Size 2" 186

(5) Screen: Size 2, Length 20

(6) Were any formations sealed against pollution?


yes, no.

If YES depth of formation (USGS E-1 of #5)

Why

Drillers Remarks:

CODED

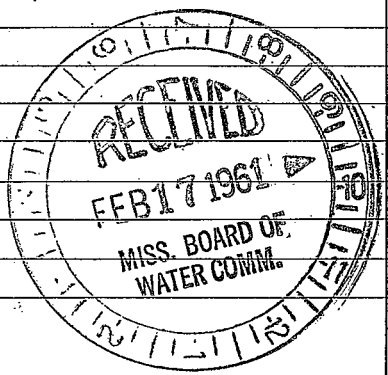

(Use Back Side)

Well No.

