

coded

F 27

Montgomery  
F27  
4-67  
Elec Log

MISSISSIPPI  
BOARD OF WATER COMMISSIONERS  
416 North State Street  
Jackson, Mississippi 39201

CODED

WATER WELL DRILLERS LOG

4-27 1967 date well completed  
Layne Central Co. firm name  
Montgomery county well located

LANDOWNER: City of Winona

description of formations encountered  
from to

Winona, Miss.  
(mailing address)



SANDY CLAY	0	12
LOOSE SANDY CLAY	12	28
LOOSE SAND	28	34
BLUE CLAY	34	88
CLAY + SAND STREAKS	88	102
HARD CLAY	102	118
ROCK	118	120
SANDY CLAY	120	150
HARD CLAY	150	205
CLAY + STREAKS OF SAND	205	227
CLAY	227	241
SANDY CLAY	241	254
SAND	254	291
BLUE CLAY	291	300

WELL LOCATION: NW, NE, NE  
sec. 25 T. 19 N. R. 5 E  
S W  
miles E of Winona  
(distance) (direction) (nearest town)

WELL PURPOSE: Municipal  
(home, irrigation, municipal, industrial)

WELL COMPLETION DATA:

- (1) diameter (inches) 16"
- (2) total depth (feet) 293'
- (3) static water level (feet) 102 below top of ground.
- (4) casing Black St. 242' (material) (depth)  
16" (size) if telescope see back.
- (5) screen 40' 248' (length) (depth to top)  
10" Stainless Steel (size) (material)
- (6) pump 30 412 (HP) (yield gpm)  
Electric (type power)
- (7) electric log YES (E-log #27) (yes or no)  
U.S.G.S. (organization running log)
- (8) how well bottom plugged Solid Bottom

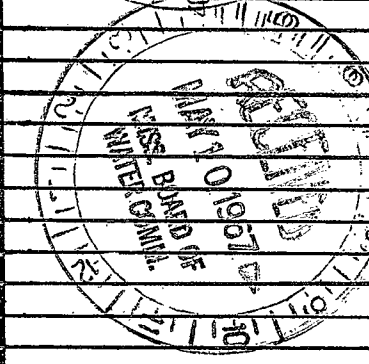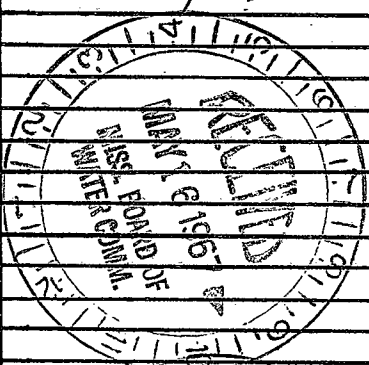

DRILLERS REMARKS:



If well telescopes please  
sketch and show depths.

GROUND LEVEL


SECTION \_\_\_\_\_

Please indicate well location X.

ADDITIONAL INFORMATION

If more than one screen,  
show locations of each on sketch.