

Montgomery
 5 G 1
 7-67

MISSISSIPPI
 BOARD OF WATER COMMISSIONERS
 416 North State Street
 Jackson, Mississippi 39201

CODED
 CODE

WATER WELL DRILLERS LOG

CODED

July 1967 Jack Martin Montgomery
 date/well completed firm name county well located

LANDOWNER: E. B. McCann
 Winona Rt 2


description of formations encountered	from	to
Sand	0	19
Mud	19	49
Sand	48	61
Mud + Sand	61	106
Sand	106	124
Mud	124	134
Sand	134	166
Mud	166	193
Sand	193	220
Sand - mud streaks	220	248
Sand	248	274
Mud - Sand streaks	274	318
Sand	318	360

(mailing address)

WELL LOCATION:
 sec. 28 T 19 N R 6 E
 4 miles East of Winona
 (distance) (direction) (nearest town)


WELL PURPOSE: Home
 (home, irrigation, municipal, industrial)

- WELL COMPLETION DATA:
- (1) diameter (inches) 4
 - (2) total depth (feet) 360
 - (3) static water level (feet) 100 below top of ground.
 - (4) casing Galv pipe 360 (material) (depth)
 4 1/2 (size) if telescope see back.
 - (5) screen 10 350 (length) (depth to top)
 2" (size) Stainless Steel (material)
 - (6) pump 1 10 (HP) (yield gpm)
 Elec (type power)
 - (7) electric log (yes or no)
 (organization running log)
 - (8) how well bottom plugged Cap

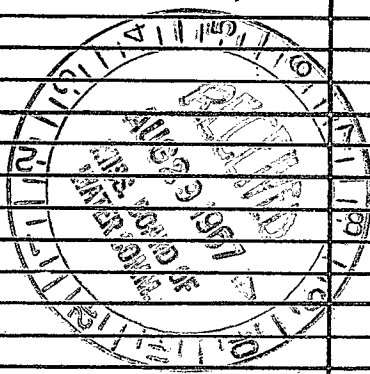

DRILLERS REMARKS:

If well telescopes please sketch and show depths.

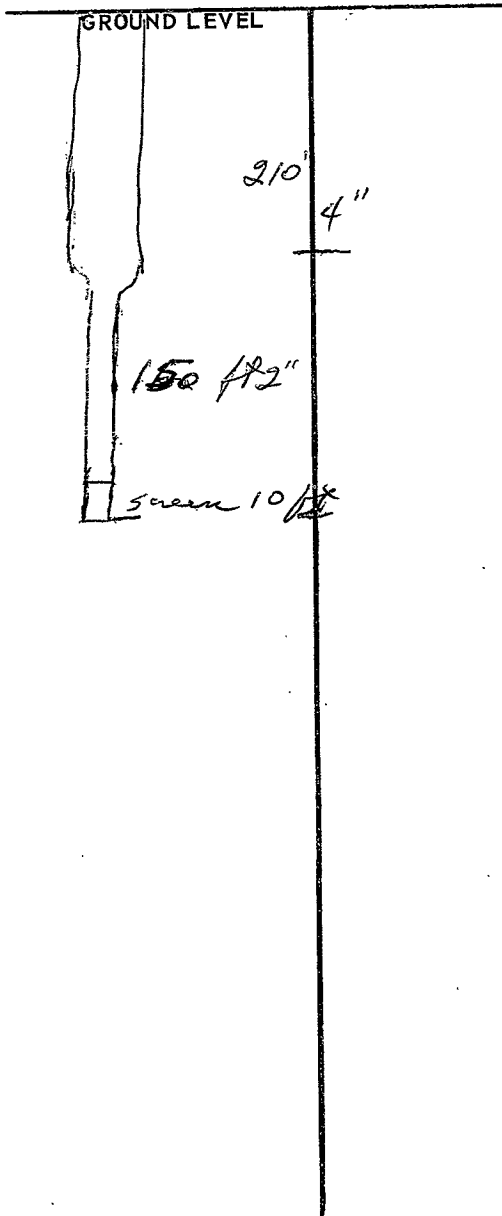

SECTION 28

Please indicate well location X.

ADDITIONAL INFORMATION

If more than one screen, show locations of each on sketch.