

WATER WELL DRILLERS LOG

CODED

G2
8-24-62

Date: Aug 24, 1962, Driller: Robert E Rathiff Co County: Montgomery
(Name)

(1) Owner of Land: Joe Lishman
(Name)
Winona, Mississippi
(Address) 29 196
(2) Location: 1 1/2 miles East of Winona
(distance) (direction) (Nearest Town)
(3) Topography: hilly
(Hilly) (Flat) (Level)
(4) Purpose of Well: Domestic
(Domestic Irrigation
Municipal, Industrial, Other)

Description & Color of Materials Sand, Clay, Red Clay, Shell, etc.	Thick- ness Feet	Depth Feet
Red Sand-Shale-rocks	0	22
Shale rocks	22	44
Shale-rocks	44	66
Shale-sand-rocks	66	88
Sandy shale	88	110
Sandy shale	110	132
Shale-rock 151	132	154
Sand. good	154	176


Information upon completion of well:

(1) Diameter 2 inches.
(2) Total Depth 176 feet.
(3) Water Level 83 feet below top of ground.
(4) Cased to depth, Size 2"
(5) Screen: Size 2", Length 5'
(6) Were any formations sealed against pollution?
✓ yes, no.

If YES depth of formation cased
Why

Drillers Remarks:

CODED

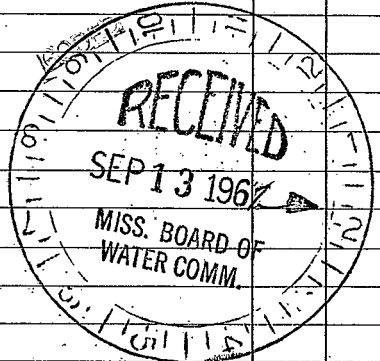

(Use Back Side)

Well No.

