

G3

WATER WELL DRILLERS LOG

Date: MAR 25, 1963, Driller: DELTA DRILLING Co COUNTY MONTGOMERY
 (Name)

(1) Owner of Land: FRANK SPROLES - COOPER FARMS
 (Name)
WINONA, MISS
 (Address)

(2) Location: SW 1/4, NW 1/4, Sec. 4 T19N R6E
 _____ miles _____ of _____
 (distance) (direction) (Nearest Town)

(3) Topography: FLAT HILLY
 (Hilly) (Flat) (Level)

(4) Purpose of Well: DOMESTIC
 (Domestic Irrigation
 Municipal, Industrial, Other)

Description & Color of Materials Sand, Clay, Red Clay, Shell, etc.	Thick- ness Feet	Depth Feet
<u>CLAY</u>	<u>24</u>	<u>24</u>
<u>RED SAND</u>	<u>105</u>	<u>129</u>
<u>SHALE</u>	<u>65</u>	<u>194</u>
<u>SAND w/ROCK</u>	<u>20</u>	<u>214</u>
<u>SHALE</u>	<u>39</u>	<u>253</u>
<u>SAND</u>	<u>84</u>	<u>337</u>

CODED

Information upon completion of well:

(1) Diameter 4 inches.

(2) Total Depth 337 feet.

(3) Water Level 185 feet below top of ground.

(4) Cased to 327, Size 2.50' - 4" / 77' - 2"


(5) Screen: Size 2", Length 10'

(6) Were any formations sealed against pollution?
 _____ yes, _____ no.

If YES depth of formation _____
 Why _____

Drillers Remarks: DEEP WELL RED

JACKET - 1 H.P SUBMERSIBLE PUMP - SET 231' IN WELL - 4 X 2" STEEL REDUCER -

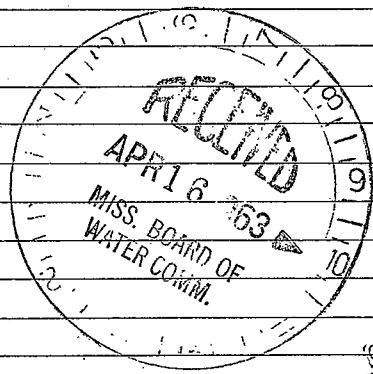

CODED

(Use Back Side)

Well No.

