

MONTGOMERY
G5
7-73

MISSISSIPPI
 BOARD OF WATER COMMISSIONERS
 416 North State Street
 Jackson, Mississippi 39201

CODED

WATER WELL DRILLERS LOG

July 1973 Jack Martin Well Service Montgomery
 date well completed firm name county well located

LANDOWNER: Henry Logan

description of formations encountered

from to

Kilmichael, Miss
 (mailing address)

Pipe Clay 0 8

Sand 8 15

WELL LOCATION:

sec. 36 T 19 S R 6 E W

Pipe Clay 15 33

3 miles West of Kilmichael
 (distance) (direction) (nearest town)

Sand 33 45

WELL PURPOSE: home
 (home, irrigation, municipal, industrial)

Coastal Sand 45 52

CODED
Sand 52 63

WELL COMPLETION DATA:

(1) diameter (inches) 2"

(2) total depth (feet) 63'

(3) static water level (feet) 28 below above top of ground.

(4) casing plastic, 58'
 (material) (depth)

2"
 (size) if telescope see back.

(5) screen 5', 58'
 (length) (depth to top)

2", plastic
 (size) (material)

(6) pump 1/2 7
 (HP) (yield gpm)

Elec.
 (type power)

(7) electric log _____
 (yes or no)

 (organization running log)

(8) how well bottom plugged cap.


DRILLERS REMARKS: On Hwy 82

JUL 30 1973

MISS. BD. OF
 WATER CONTROL
 JACOBSON, CHAIRMAN

If well telescopes please sketch and show depths.

GROUND LEVEL

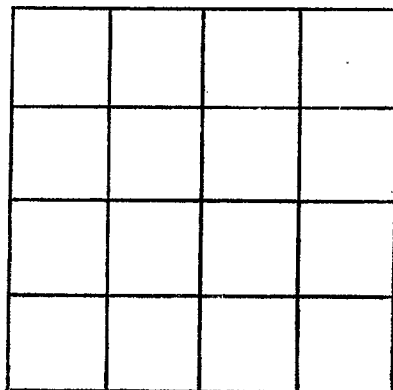

SECTION _____

Please indicate well location X.

ADDITIONAL INFORMATION

If more than one screen, show locations of each on sketch.