

H2

6-18-66

WATER WELL DRILLERS LOG

Date: 6-18-1966, Driller: Smith Forge & Welding County: Montgomery
 (Name)

(1) Owner of Land: Leander Edwards
 (Name)
R1 Box 79
 (Address)

(2) Location: NE 1/4, SE 1/4, Sec. 30 T17R7,
5 miles NW of Kilmichael,
 (distance) (direction) (Nearest Town)

(3) Topography: Hilly
 (Hilly) (Flat) (Level)

(4) Purpose of Well: Domestic
 (Domestic Irrigation
 Municipal, Industrial, Other)

Information upon completion of well:


- (1) Diameter 2 inches.
- (2) Total Depth 230 feet.
- (3) Water Level 75 feet below top of ground.
- (4) Cased to 226, Size 3"
- (5) Screen: Size 1/4, Length 6'
- (6) Were any formations sealed against pollution?
no yes, no

If YES depth of formation _____

Why _____

Drillers Remarks: _____

Description & Color of Material Sand, Clay, Red Clay, Shell, etc.	Thick-ness Feet	Depth Feet
yellow clay	12	12
sand rock	4"	
yellow sand	30	42
yellow sand		
mixture of black clay	10	52
black clay	12	64
black clay sand mixture	30	94
black clay		
trace of sand	6	120
a very coarse gray sand about		
black clay mixture	12	132
a green fine sand clay mixture		
is and out	60	192
black clay	10	202
white fine sand	15	217
a good grad of white sand	13	230

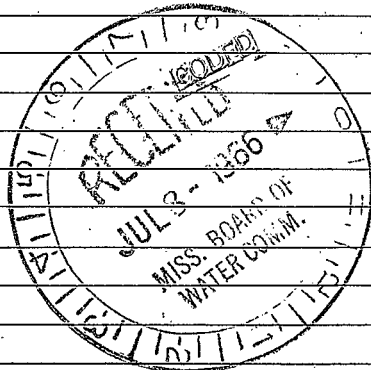

RECEIVED

(Use Back Side)

15 Well No.

