

Montgomery
H/3
10-66

MISSISSIPPI BOARD OF WATER COMMISSIONERS

WATER WELL DRILLERS LOG

Date: 10-12, 1966, Driller: Butane Gas Co. County: Montgomery
(Name)

INDEX

(1) Owner of Land:	Description & Color of Materials Sand, Clay, Red Clay, Shell, etc.	Thick- ness Feet	Depth Feet
<u>R.R. Sanford</u> (Name)	<u>Clay</u>	<u>50</u>	<u>50</u>
<u>Rt. 1, Kilmichael, Miss.</u> (Address)	<u>Shale</u>	<u>160</u>	<u>210</u>
(2) Location: <u>SW 1/4, SE 1/4, Sec 30 T19 R1E</u>	<u>Clay</u>	<u>103</u>	<u>313</u>
<u>3</u> miles <u>NW</u> of <u>Kilmichael</u> (distance) (direction) (Nearest Town)	<u>Sand + Shale</u>	<u>77</u>	<u>390</u>
(3) Topography: <u>X</u> (Hilly) (Flat) (Level)	<u>Shale</u>	<u>50</u>	<u>440</u>
(4) Purpose of Well: <u>Domestic</u> (Domestic Irrigation Municipal, Industrial, Other)	<u>Brown Sand</u>	<u>50</u>	<u>490</u>
	<u>Sand</u>	<u>30</u>	<u>520</u>

Information upon completion of well:

(1) Diameter 4 3/4 inches.

(2) Total Depth 520 feet.

(3) Water Level 80' feet below top of ground.

(4) Cased to 490, Size 4 X 2.

(5) Screen: Size 2", Length 20'.


(6) Were any formations sealed against pollution?
_____ yes, X no.

If YES depth of formation _____

Why _____

Drillers Remarks: _____

INDEX

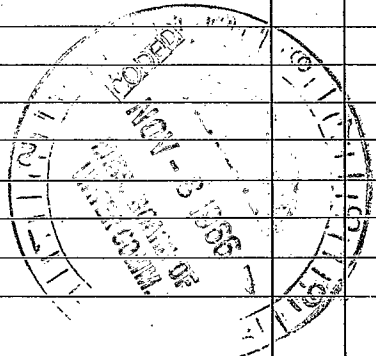

Well No.

(Use Back Side)

