

Montgomery
H4
10-67

MISSISSIPPI
BOARD OF WATER COMMISSIONERS
416 North State Street
Jackson, Mississippi 39201

CODED

WATER WELL DRILLERS LOG

MONTGOMERY

Oct 17 67 19
date well completed

BUTANE GAS CO
firm name

GREENWOOD

~~Montgomery~~
county well located

LANDOWNER:

Jimmy Green

description of formations encountered

from

to

Ira Bena, Miss
(mailing address)

CLAY	1	80
SHALE	80	120
FINE SAND	120	130
BROWN SAND.	130	152

WELL LOCATION:

sec. 1 T. 19 N. R. 7 E.
1/2 miles S of Lodi
(distance) (direction) (nearest town)

WELL PURPOSE: Home
(home, irrigation, municipal, industrial)

WELL COMPLETION DATA:

- (1) diameter (inches) 2"
- (2) total depth (feet) 146'
- (3) static water level (feet) 96 below top of ground.
- (4) casing Cmu, 136', (material), (depth)
- 2" (size) if telescope see back.
- (5) screen 10', 136' (length), (depth to top)
- 2" STAINLESS STEEL (size), (material)
- (6) pump 1 (HP), 5 (yield gpm)
- Electric (type power)
- (7) electric log No (yes or no)


CODED

(organization running log)

(8) how well bottom plugged


Back Pressure Valve

DRILLERS REMARKS:

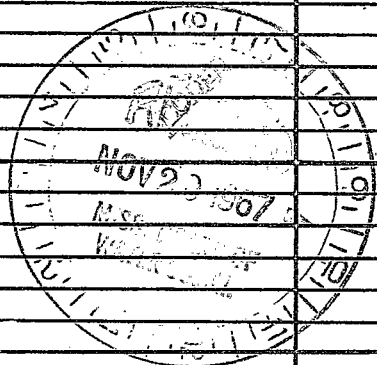

If well telescopes please sketch and show depths.

GROUND LEVEL

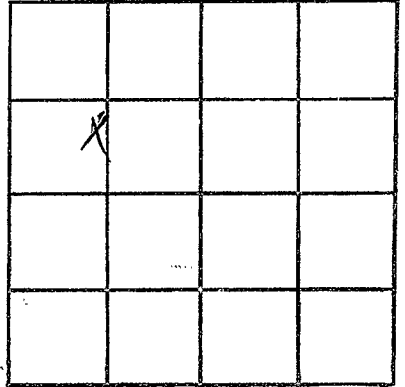

SECTION 1

Please indicate well location X.

ADDITIONAL INFORMATION

If more than one screen, show locations of each on sketch.