

MONTGOMERY  
 3 H5  
 5-68

MISSISSIPPI  
 BOARD OF WATER COMMISSIONERS  
 416 North State Street  
 Jackson, Mississippi 39201

CODED

WATER WELL DRILLERS LOG

5-3 1968 Thomas & Son Montgomery  
 date well completed firm name county well located

LANDOWNER: Mr. Borchfield

| description of formations encountered | from | to |
|---------------------------------------|------|----|
|---------------------------------------|------|----|

Kilmichel, Miss.

|            |    |    |
|------------|----|----|
| DIRT       | 0  | 10 |
| Black DIRT | 10 | 38 |
| rock       | 38 | 40 |

(mailing address)

WELL LOCATION:

sec. 36 T. 19 N. R. 7 E  
 S W  
3 1/2 miles N. E. of Kilmichel  
 (distance) (direction) (nearest town)

|                        |    |     |
|------------------------|----|-----|
| Black DIRT             | 40 | 45  |
| STRs FINE SAND & CHALK | 55 | 94  |
| Coarse SAND            | 94 | 155 |

WELL PURPOSE:

(home, irrigation, municipal, industrial)

|                 |     |     |
|-----------------|-----|-----|
| HARD Grey CHALK | 155 | 189 |
| FINE SAND & " " | 189 | 200 |
| ROCK 6" THICK   | 200 |     |

WELL COMPLETION DATA:

- (1) diameter (inches) 2
- (2) total depth (feet) 465
- (3) static water level (feet) 8 below top of ground. above
- (4) casing Galv. 398  
 (material) (depth)  
2 " if telescope see back.  
 (size)
- (5) screen NONE  
 (length) (depth to top)  
 (size) (material)
- (6) pump 3/4 8  
 (HP) (yield gpm)  
Elec  
 (type power)
- (7) electric log NO  
 (yes or no)  
 (organization running log)
- (8) how well bottom plugged

|                   |     |     |
|-------------------|-----|-----|
| Grey CHALK        | 200 | 215 |
| FINE SAND & CHALK | 215 | 227 |
| HARD Black DIRT   | 227 | 247 |

|              |     |     |
|--------------|-----|-----|
| SAND & CHALK | 247 | 253 |
| Blue DIRT    | 253 | 264 |
| SAND & CHALK | 264 | 269 |

|                   |     |     |
|-------------------|-----|-----|
| Blue DIRT         | 269 | 275 |
| Slate like Rock   | 275 | 285 |
| FINE SAND & CHALK | 285 | 295 |

|            |     |     |
|------------|-----|-----|
| Blue CHALK | 295 | 313 |
| FINE SAND  | 313 | 325 |
| Blue CHALK | 325 | 386 |


|                   |     |     |
|-------------------|-----|-----|
| HARD Grey CHALK   | 386 | 404 |
| Grey (Green) SAND | 404 | 465 |

DRILLERS REMARKS:

MAY 27 1968  
 MISS. BD. OF  
 WATER COMM.

If well telescopes please sketch and show depths.

GROUND LEVEL

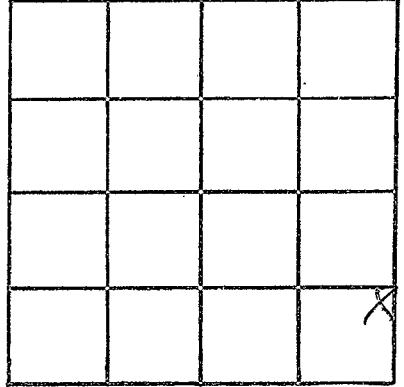

SECTION 36

Please indicate well location X.

ADDITIONAL INFORMATION

If more than one screen, show locations of each on sketch.