

MONTGOMERY
H 6
9-23-70

MISSISSIPPI
BOARD OF WATER COMMISSIONERS
416 North State Street
Jackson, Mississippi 39201

CODED

WATER WELL DRILLERS LOG

9-23-1970 Smith Well Drilling Inc Montgomery
date well completed Laddell firm name county well located

LANDOWNER: Laddell Flowers
R1 Box 45
Kilmichael miss
(mailing address)

WELL LOCATION:
sec. 12 T. 19 N R. 7 E
8 miles NE of Kilmichael
(distance) (direction) (nearest town)

WELL PURPOSE: Home
(home, irrigation, municipal, industrial)

- WELL COMPLETION DATA:
- (1) diameter (inches) 2
 - (2) total depth (feet) 178
 - (3) static water level (feet) 40 below above top of ground.
 - (4) casing 2" plastic / 170
(material) (depth)
2x1 1/4 if telescope see back.
(size)
 - (5) screen 6' / 172
(length) (depth to top)
6x1 1/4 x 90 stainless steel
(size) (material)
 - (6) pump 1 / About 450 GPH
(HP) (yield gpm)
Electricity
(type power)
 - (7) electric log NO
(yes or no)
 - (organization running log)
 - (8) how well bottom plugged

description of formations encountered	from	to
red clay	0	18
sand gravel	18	21
blue clay	21	62
black clay	62	70
blue clay thin layers of rock	70	83
blue clay gray		
sand mixture	83	117
blue sand	117	130
gray sand	130	145
very good grade of gray sand	145	178

CODED

SEP 29 1970

DRILLERS REMARKS:


MISS. BD. OF
WATER COMM.

If well telescopes please sketch and show depths.

GROUND LEVEL

2" Plastic 170 ft

1 1/4" Screen 6 ft

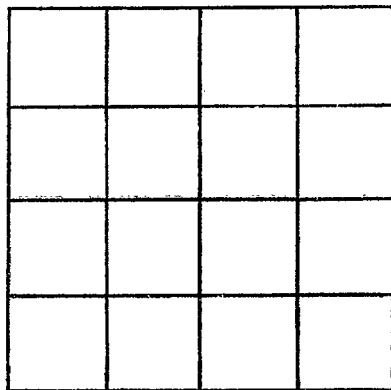

SECTION _____

Please indicate well location X.

ADDITIONAL INFORMATION

If more than one screen, show locations of each on sketch.