

Montgomery  
H 8  
5-7-72

MISSISSIPPI  
BOARD OF WATER COMMISSIONERS  
416 North State Street  
Jackson, Mississippi 39201

**CODED**

WATER WELL DRILLERS LOG

May 7 1972 Norman Echols Montgomery Co.  
date well completed firm name county well located

LANDOWNER: Dr. Robert Tate  
West Point, Miss.  
(mailing address)  
WELL LOCATION: N. of Michael, Miss.  
sec. 33 T. 19 N. R. 7 E. 1/4  
2 miles West of  
(distance) (direction) (nearest town)

description of formations encountered	from	to
Top Soil, Red Clay	0	15
Sandy clay	15	58
Beach, thin	50	147
White Sand	147	207

WELL PURPOSE: Camp House  
(home, irrigation, municipal, industrial)

- WELL COMPLETION DATA:
- (1) diameter (inches) 4
  - (2) total depth (feet) 207
  - (3) static water level (feet) 82' below top of ground.
  - (4) casing 4" casing (material) (depth) (size) if telescope see back.
  - (5) screen 10' 5" screen (length) 9" pipe (depth to top) (size) (material)
  - (6) pump L (HP) 5 (yield gpm)  
Electric (type power)
  - (7) electric log (yes or no)
  - (organization running log)
  - (8) how well bottom plugged


CODED	147	207
10' 5" screen	99	
9" pipe	211	
	207	

DRILLERS REMARKS:

APR 2 1972

If well telescopes please sketch and show depths.

GROUND LEVEL

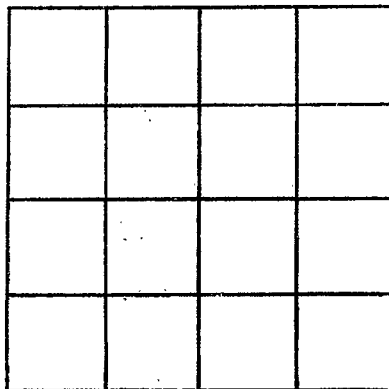

SECTION \_\_\_\_\_

Please indicate well location X.

ADDITIONAL INFORMATION

If more than one screen, show locations of each on sketch.