

**MONTGOMERY**  
 H 10  
 3-74

MISSISSIPPI  
 BOARD OF WATER COMMISSIONERS  
 416 North State Street  
 Jackson, Mississippi 39201

**CODED**

**WATER WELL DRILLERS LOG**

March 19 74 *Luttrell Kelly & Sons* firm name *Montgomery* county well located  
 date well completed

LANDOWNER:  
*P.J. Patridge*  
*Rt 1 Stewart, Miss,*  
 (mailing address)

description of formations encountered	from	to
<i>clay</i>	<i>0</i>	<i>180</i>
<i>sand</i>	<i>180</i>	<i>200</i>

WELL LOCATION:  
 sec. *1* T *19* N R. *7* E  
*1/4* miles *S* of *Lodi*  
 (distance) (direction) (nearest town)

WELL PURPOSE:  
 (home, irrigation, municipal, industrial)

WELL COMPLETION DATA:

(1) diameter (inches) *4x2"*

(2) total depth (feet) *280'*

(3) static water level (feet) *60* below above top of ground.

(4) casing *4" plastic*, *200*  
 (material) (depth)  
*4x2* If telescope see back.  
 (size)

(5) screen *20'*, *200*  
 (length) (depth to top)  
*2"*, *stainless steel*  
 (size) (material)

(6) pump *1 HP*, *18 gal*  
 (HP) (yield gpm)  
*electricity*  
 (type power)

(7) electric log *no*  
 (yes or no)

(organization running log)

(8) how well bottom plugged *backers*

**CODED**

RECEIVED  
 JUL 12 1974

DRILLERS REMARKS:

MISS. BD. OF WATER COM


If well telescopes please sketch and show depths.

GROUND LEVEL

200'  
pvc  
4" pipe

← bad seal

20'  
stainless  
steel  
screen

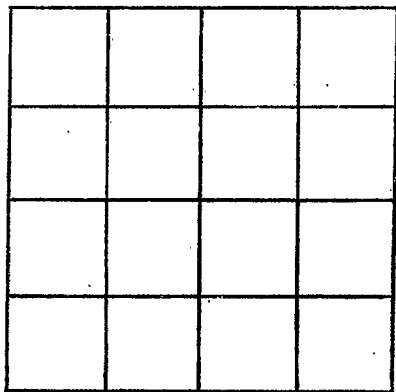

SECTION \_\_\_\_\_

Please indicate well location X.

ADDITIONAL INFORMATION

If more than one screen,  
show locations of each on sketch.