

MISSISSIPPI BOARD OF WATER COMMISSIONERS

Well No. 1

WATER WELL DRILLERS LOG

E LOG # 20

Date: 5-13-1966, Driller: Layne-Central Co.

County: Montgomery

(Name)

CODED

(1) Owner of Land: Miss. Forestry Comm.

(Name)

Winona, Mississippi

(Address)

15185

(2) Location: NE 1/4, SE 1/4, Sec. 10, T. 10 N., R. 10 W.

_____ miles _____ of _____
(distance) (direction) (Nearest Town)

(3) Topography:

(Hilly) (Flat) (Level)

(4) Purpose of Well: Nursery at Winona

(Domestic Irrigation
Municipal, Industrial, Other)

CODED

Information upon completion of well:

(1) Diameter 10 inches.

(2) Total Depth 328 feet.

(3) Water Level 64 feet below top of ground.

(4) Cased to 260', Size 10"

(5) Screen: Size 6", Length 60'

(6) Were any formations sealed against pollution?

yes, _____ no.


If YES depth of formation 260'

Why required

Drillers Remarks:

Description & Color of Materials Sand, Clay, Red Clay, Shell, etc.	Thickness Feet	Depth Feet
0-35 clay	35	
35-65 sand shale	30	
65-132 fine sand-stks shale	67	
132-260 hard sand-stks shale	128	
260-324 sand	64	
324-334 shale	10	

505B
@ 80' 35'
325 gpm

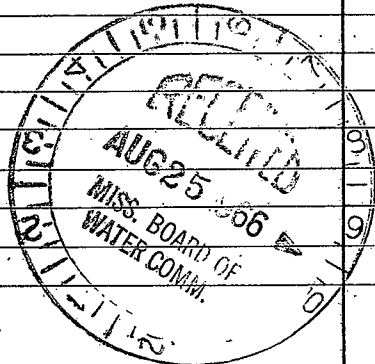

(Use Back Side)

Well No.

