

Note: This is a test hole,
Prod. well compl. 12-68 (?)
by Herndon-Homan.
E.H.B. (J10)

coded

MISSISSIPPI
BOARD OF WATER COMMISSIONERS
416 North State Street
Jackson, Mississippi 39201

CODED

WATER WELL DRILLERS LOG

Montgomery
J 4
4-67
Elec Log

APRIL 5, 1967 date well completed
DELTA DRILLING COMPANY firm name
MONTGOMERY county well located

LANDOWNER: S. WINONA WATER ASSN
WINONA, MISS -

Description of formations encountered	from	to
CLAY	82	82
SAND	41	123
CLAY	21	144
SAND	83	227
CLAY	59	286
SAND	22	308
CLAY	127	435
Fine sand	44	479
CLAY	139	618
Shale	79	697
SAND	129	826
Shale	42	868
SAND	44	912
CLAY	26	938
Shale	60	998
CLAY	16	1014



WINONA, MISS -
(mailing address)

WELL LOCATION: SW 1/4 NE 1/4
sec 6 T. 18 N R. 6 E
3 miles S of WINONA
(distance) (direction) (nearest town)

WELL PURPOSE:
(home, irrigation, municipal, industrial)

WELL COMPLETION DATA:

- (1) diameter (inches) 4" - 275'
2" - 926'
- (2) total depth (feet) 1014'
- (3) static water level (feet) 162 below top of ground.
- (4) casing STEEL, 926'
(material) (depth)
2" if telescope see back.
(size)
- (5) screen 10' 916'
(length) (depth to top)
2 STAINLESS STEEL
(size) (material)
- (6) pump 3/4 9
(HP) (yield gpm)
ELEC
(type power)
- (7) electric log YES (USGS # 25)
(yes or no)
MISS. GEO. SURVEY
(organization running log)
- (8) how well bottom plugged B. P. VALVE

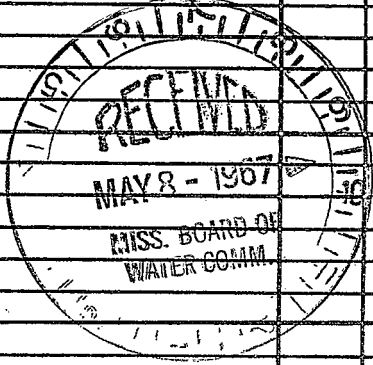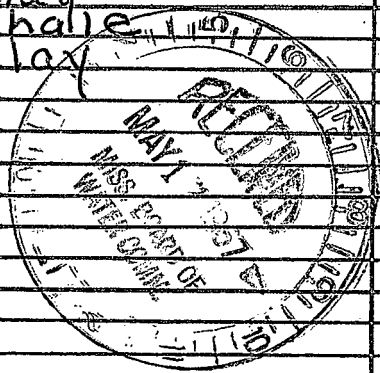

DRILLERS REMARKS: 1-GR. HARD
8.4- Ph-
O.B. FE.

