

WATER WELL DRILLERS LOG

Garf

8 J6
7-21-60

Date: 7-21, 1960, Driller: *Smith & Presley* County: *Montgomery*
Mrs Mary Ware Shofner (Name)

(1) Owner of Land: *Mrs Shofner*
(Name)
Winona, Miss.
(Address)

(2) Location: *Wk W's lease Sec. 6 T18 R6*
1 1/2 miles East of *Winona*
(distance) (direction) (Nearest Town)

(3) Topography: *Hilly*
(Hilly) (Flat) (Level)

(4) Purpose of Well: *Domestic*
(Domestic Irrigation
Municipal, Industrial, Other)

Description & Color of Materials Sand, Clay, Red Clay, Shell, etc.	Thick- ness Feet	Depth Feet
<i>yellow clay</i>	<i>23</i>	<i>23</i>
<i>Blue or Black Clay</i>	<i>20</i>	<i>43</i>
<i>hard blue shale</i>	<i>1/2</i>	<i>43 1/2</i>
<i>soft blue shale, trace of sand</i>	<i>8</i>	<i>51</i>
<i>about</i>		
<i>Coarse white sand</i>		
<i>mixed with a</i>		
<i>black pellet like</i>	<i>4</i>	<i>55</i>
<i>thin hard shale</i>	<i>4"</i>	<i>59</i>
<i>green sand</i>	<i>29</i>	<i>84</i>
<i>Clay</i>	<i>1</i>	<i>85</i>

Information upon completion of well:

(1) Diameter: *2"* inches.

(2) Total Depth: *176* feet.

(3) Water Level: *62* feet below top of ground.

(4) Cased to *105-71 1/4* Size *2 X 1 1/4*

(5) Screen: Size *1 1/4*, Length *6'*


(6) Were any formations sealed against pollution?
 _____ yes, no.

<i>Sand began to</i>		
<i>lighten up</i>	<i>20</i>	<i>105</i>
<i>sand mixed with blue</i>		
<i>clay</i>	<i>19</i>	<i>124</i>
<i>sand mix with blue</i>		
<i>clay</i>	<i>13</i>	<i>137</i>
<i>Block Chock Mix</i>		
<i>with sand</i>	<i>18</i>	<i>147</i>
<i>black hard shale</i>		
<i>three or four in</i>	<i>304</i>	
<i>sand mixed with</i>		
<i>shale</i>	<i>9</i>	<i>156</i>
<i>a clear sand coarse</i>		
<i>free of any mixture</i>	<i>20</i>	<i>176</i>

If YES depth of formation _____

Why _____

Drillers Remarks: *It is very difficult to describe the many colors and soils*

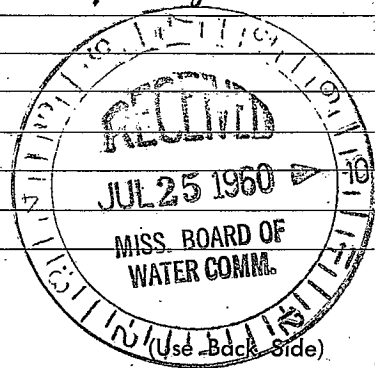

Well No. 4

