

J1

WATER WELL DRILLERS LOG

11-4-63

Date: 11-4, 1963, Driller: Thomas & Son County: Madison

(Name)

(1) Owner of Land: Mr. Ellis  
(Name)  
WINONA  
(Address)

(2) Location: NE 1/4, SE 1/4, Sec. 15 T18R5,  
4 miles S, of WINONA,  
(distance) (direction) (Nearest Town)

(3) Topography: (Flat)  
(Hilly) (Flat) (Level)

(4) Purpose of Well: (Domestic) Irrigation  
Municipal, Industrial, Other

Description & Color of Materials Sand, Clay, Red Clay, Shell, etc.	Thick- ness Feet	D Feet
Dirt	26	0
White Sand	19	20
Sandy Chalk	37	38
Grey Chalk - Few Soft Rock w/white streaks of Sand	55	75
Real coarse white Sand	9	130
		139

Information upon completion of well:

(1) Diameter 2 inches.

(2) Total Depth 139 feet.

(3) Water Level 45 feet below top of ground.

(4) Cased to 133, Size 2

(5) Screen: Size 50G, Length 6 Ft.


(6) Were any formations sealed against pollution?  
yes, V no.

If YES depth of formation \_\_\_\_\_

Why \_\_\_\_\_

Drillers Remarks: \_\_\_\_\_

ROLLED

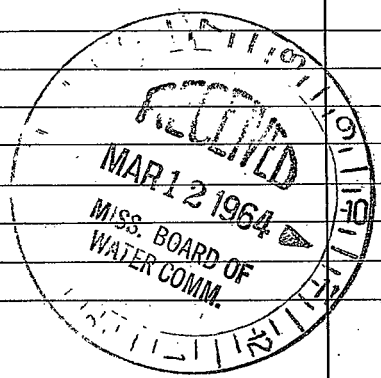

(Use Back Side)

Well No.

