

Montgomery
89
1-13-68

MISSISSIPPI
BOARD OF WATER COMMISSIONERS
416 North State Street
Jackson, Mississippi 39201

WATER WELL DRILLERS LOG

1-13-68 19 Robert E. Kattiff Co. CODED Montgomery
date well completed firm name county well located

LANDOWNER: Spanish
Bit Ranch


Winona Miss.
(mailing address)

WELL LOCATION:
sec. 15 T 18 N R 5 E
5 miles 30. of Winona
(distance) (direction) (nearest town)

WELL PURPOSE: home
(home, irrigation, municipal, industrial)

- WELL COMPLETION DATA:
- (1) diameter (inches) 4"
 - (2) total depth (feet) 404
 - (3) static water level (feet) 143 below top of ground.
 - (4) casing Plastic, 404, (material) (depth)
4" (size) if telescope see back.
 - (5) screen 20', 384 (length) (depth to top)
4" Plastic (size) (material)
 - (6) pump 2, 12 (HP) (yield gpm)
electric (type power)
 - (7) electric log No. (yes or no)
 - (organization running log)
 - (8) how well bottom plugged BPU


description of formations encountered	from	to
Red Sand	0	24
Clay + Rocks	24	45
Shale + Rocks	45	67
Sandy shale + Rocks	67	89
Sandy Shale	89	111
Sandy Shale	111	133
Sandy Shale	133	154
Sandy Shale + Rocks	154	176
Sandy shale	176	293
Green Sand	293	329
Sand	329	351
White Sand	351	412
Shale	412	418

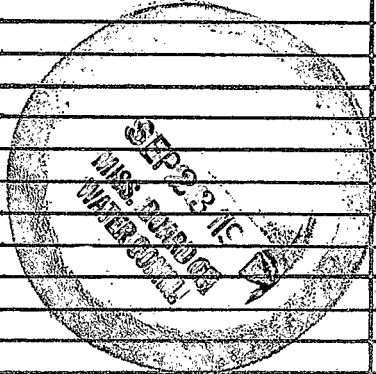

DRILLERS REMARKS:

If well telescopes please sketch and show depths.

GROUND LEVEL

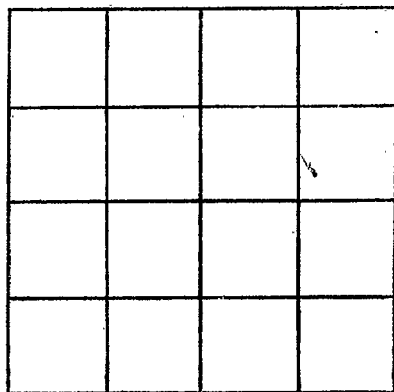

SECTION _____

Please indicate well location X.

ADDITIONAL INFORMATION

If more than one screen, show locations of each on sketch.