

Montgomery
 9 10
 4-69
 WSGS

MISSISSIPPI
 BOARD OF WATER COMMISSIONERS
 416 North State Street
 Jackson, Mississippi 39201

WATER WELL DRILLERS LOG

Hearden-Homan Well & Supply, Inc.

P. O. Box 42

Montgomery

date well completed 1969

SEANNON, MISSISSIPPI 38868

county well located

LANDOWNER:	description of formations encountered	from	to
So. Winona Water Ass.	Red clay	0	12
Winona Miss. (mailing address)	Sand	12	21
	Blue clay	21	47
	Blue clay	47	142
	Sand	142	180
	Blue clay (quarry)	180	440
	Loess	440	445
	Sand	445	480
	Clay	480	510
	Gravel	510	

WELL LOCATION:

sec. 6 T 18 N R 6 E
 (distance) miles S of Winona (direction) (nearest town)

WELL PURPOSE: Commercial (home, irrigation, municipal, industrial)

WELL COMPLETION DATA:

- (1) diameter (inches) 6
- (2) total depth (feet) 510
- (3) static water level (feet) 170 below top of ground
- (4) casing steel 4" (material) 443 (depth)
- 6 (size) if telescope see back.
- (5) screen 31' (length) 410' (depth to top) 448-479'
- 3" (size) 55 (material)
- (6) pump 5 (HP) 50 (yield gpm)
- electric (type power)
- (7) electric log yes (USGS #27) (yes or no) USGS
- (organization running log)
- (8) how well bottom plugged B/W

MAY 26 1969

MISS. BD. OF WATER COMMISSIONERS


DRILLERS REMARKS:



If well telescopes please sketch and show depths.

GROUND LEVEL

6" casing
443'

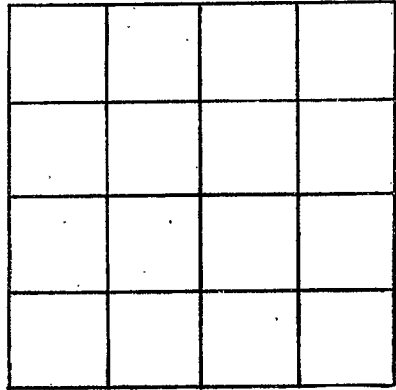

SECTION 6

Please indicate well location X.

ADDITIONAL INFORMATION

Lead Seal
423'

445

479

If more than one screen, show locations of each on sketch.

31' Screens

31' Seal
30'

510'