


If well telescopes please sketch and show depths.

GROUND LEVEL

8' 4" 2"
15' 11/4" P. Bowen

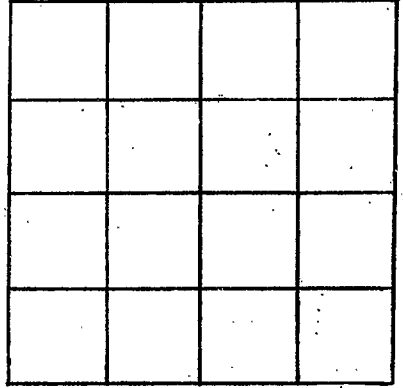

SECTION 2

Please indicate well location X.

ADDITIONAL INFORMATION

If more than one screen, show locations of each on sketch.