

Montgomery
 J 12
 9-23-69

MISSISSIPPI
 BOARD OF WATER COMMISSIONERS
 416 North State Street
 Jackson, Mississippi 39201

WATER WELL DRILLERS LOG

9-23-1969 date well completed
 Smith Well Drilling Co. firm name
 Montgomery county well located

LANDOWNER: Jay Lee Gary
 R3
 Kilmichael Miss
 (mailing address)

WELL LOCATION:
 sec. 1 T 16 N R 6 E
 S W
 2 miles W of Kilmichael
 (distance) (direction) (nearest town)

WELL PURPOSE: Home
 (home, irrigation, municipal, industrial)

WELL COMPLETION DATA:
 (1) diameter (inches) 2"
 (2) total depth (feet) 140
 (3) static water level (feet) 95 below above top of ground.
 (4) casing 2 galv. 126' (material) (depth)
 2x1/4" if telescope see back. (size)
 (5) screen 6' 134' (length) (depth to top)
 1/4" stainless steel (size) (material)
 (6) pump 1/2 Rod about 275 PH (HP) (yield gpm)
 Electricity (type power)
 (7) electric log NO (yes or no)

description of formations encountered	from	to
red clay	0	18
red sand	18	38
white sand	38	45
white sand	45	47
white sand		
white clay mixture	47	80
rock	80	82
black clay	82	89
sand & white clay mixture		
good grade of sand	89	125
	125	140

(organization running log)

OCT 3 - 1969

MISS. BU. OF WATER CONSERV.

(8) how well bottom plugged
 DRILLERS REMARKS: FOR


If well telescopes please sketch and show depths.

GROUND LEVEL

12 ft 2"

12 ft 11/4"

6 ft screen

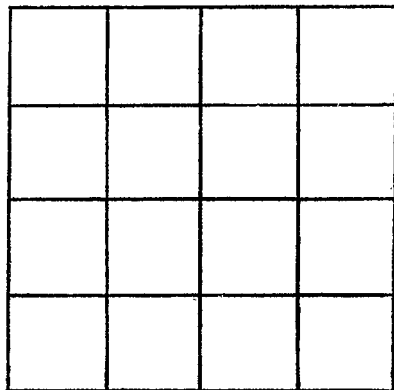

SECTION 1

Please indicate well location X.

ADDITIONAL INFORMATION

If more than one screen, show locations of each on sketch.