

Montgomery
J 13, 0
9-23-69

MISSISSIPPI
 BOARD OF WATER COMMISSIONERS
 416 North State Street
 Jackson, Mississippi 39201

WATER WELL DRILLERS LOG

9-23 1969 Thomas Son Montgomery
 date well completed firm name county well located

LANDOWNER:	description of formations encountered	from	to
<u>Mr. Arnold Herron</u>			
<u>Kilmichael, M. 35-</u>	<u>Hard Dirt</u>	<u>0</u>	<u>21</u>
	<u>CHALK & STRS course</u>	<u>21</u>	<u>38</u>
	<u>Red SAND</u>		
	<u>Black Dirt</u>	<u>38</u>	<u>58</u>
	<u>White SAND</u>	<u>58</u>	<u>69</u>
(mailing address)			
WELL LOCATION: sec. <u>23</u> T. <u>18</u> N R. <u>6</u> E S W <u>4</u> miles <u>SW</u> of <u>Kilmichael</u> (distance) (direction) (nearest town)			
WELL PURPOSE: (home, irrigation, municipal, industrial)			
WELL COMPLETION DATA:			
(1) diameter (inches) <u>2</u>			
(2) total depth (feet) <u>69</u>			
(3) static water level (feet) <u>40</u> ^{below} above top of ground.			
(4) casing <u>PVC</u> , <u>64</u> (material) (depth) <u>2</u> if telescope see back. (size)			
(5) screen <u>5</u> , <u>64</u> (length) (depth to top) <u>1/4" 95/100</u> <u>S.S.</u> (size) (material)			
(6) pump <u>1</u> , <u>5</u> (HP) (yield gpm) <u>Elec.</u> <u>old pump</u> (type power)			
(7) electric log <u>No</u> (yes or no)			
(organization running log)			
(8) how well bottom plugged			


OCT 6 1969

MISS. BD. OF WATER COMMISSIONERS

DRILLERS REMARKS:

If well telescopes please sketch and show depths.

GROUND LEVEL

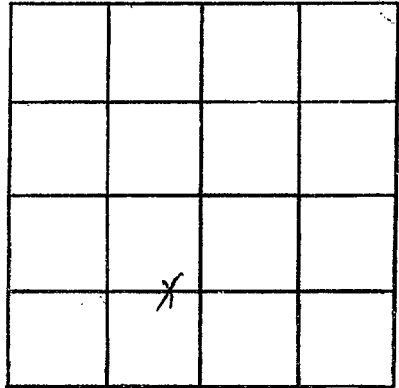

SECTION 23

Please indicate well location X.

ADDITIONAL INFORMATION

If more than one screen,
show locations of each on sketch.