

Montgomery  
 J 15  
 6-1-70

MISSISSIPPI  
 BOARD OF WATER COMMISSIONERS  
 416 North State Street  
 Jackson, Mississippi 39201

3 DB WATER WELL DRILLERS LOG

June 1 1970 Thomas & Son Montgomery  
 date well completed firm name county well located


LANDOWNER: Mr. C. R. Patterson	Description of formations encountered	from	to
	Red Clay	0	15
Kilmickel, Miss	Red Sand & Chalk	15	80
(mailing address)	CHALK	80	86
	Coarse Sand	86	94
<b>WELL LOCATION:</b> sec. 10 T. 130 S. R. 6 E 147 4 1/2 miles W of Kilmickel (distance) (direction) (nearest town)			
<b>WELL PURPOSE:</b> (home, irrigation, municipal, industrial)			
<b>WELL COMPLETION DATA:</b>			
(1) diameter (inches) 2			
(2) total depth (feet) 94			
(3) static water level (feet) 70 below top of ground			
(4) casing PVC 98 (material) (depth)			
2 (size) if telescope see back.			
(5) screen 6 98 (length) (depth to top)			
1 1/4 S.S. 8 slot (size) (material)			
(6) pump 1 6 (HP) (yield gpm)			
T&E Co. (type power)			
(7) electric log no (yes or no)			
(organization running log)			
(8) how well bottom plugged			

JUN 17 1970

DRILLERS REMARKS:

If well telescopes please sketch and show depths.

GROUND LEVEL

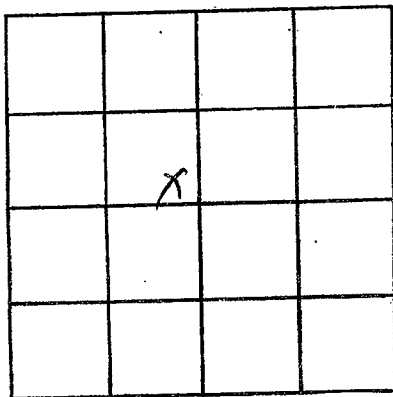

SECTION 10

Please indicate well location X.

ADDITIONAL INFORMATION

If more than one screen,  
show locations of each on sketch.