

Montgomery  
 J 16  
 6-18-70

MISSISSIPPI  
 BOARD OF WATER COMMISSIONERS  
 416 North State Street  
 Jackson, Mississippi 39201

**CODED**

WATER WELL DRILLERS LOG

June 18 1970 date well completed  
 Thomas & Son firm name  
 Montgomery county well located

LANDOWNER: Mr. HARRIS  
 Kilnickel, Miss.  
 (mailing address)  
 WELL LOCATION:  
 sec. 26 T. 14 N. R. 6 E.  
 3 miles SW of Kilnickel  
 (distance) (direction) (nearest town)

description of formations encountered	from	to
Red Clay	0	6
Hard Chalky Sand	6	36
Slate Rock	36	37
Yellow Dirty Sand	37	43
5 Fine Brown Sand & Black Dirt Strs	43	55
Slate - Black Dirt & Little Strs Sand	55	85
White Sand	85	93

WELL PURPOSE:  
 (home, irrigation, municipal, industrial)

WELL COMPLETION DATA:  
 (1) diameter (inches) 2  
 (2) total depth (feet) 93  
 (3) static water level (feet) 40 (below top of ground)  
 (4) casing PVC, 85 (material), (depth)  
 2 (size) if telescope see back.  
 (5) screen 8 (length), 85 (depth to top)  
 1/4 (size), 5-5.6 slot (material)  
 (6) pump 3/4 (HP), 6 (yield gpm)  
 Elec (type power)  
 (7) electric log NO (yes or no)  
 (organization running log)  
 (8) how well bottom plugged


**CODED**

DRILLERS REMARKS:

JUL 28 1970

If well telescopes please sketch and show depths.

GROUND LEVEL

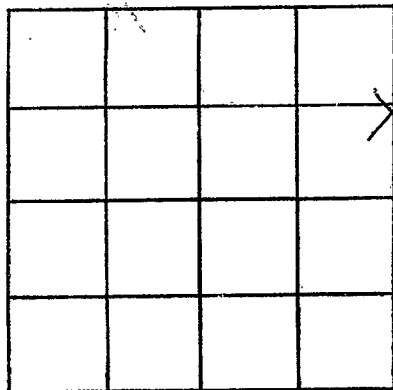

SECTION 26

Please indicate well location X.

ADDITIONAL INFORMATION

If more than one screen,  
show locations of each on sketch.