

MONTGOMERY  
JB 17  
3-26-71

MISSISSIPPI  
 BOARD OF WATER COMMISSIONERS  
 416 North State Street  
 Jackson, Mississippi 39201

**CODED**

WATER WELL DRILLERS LOG

3-26-71 19 Thomas & Son Montgomery  
 date well completed firm name county well located

LANDOWNER: Ray Meeks  
Winona, Miss.  
 (mailing address)

description of formations encountered	from	to
<u>red clay</u>	<u>0</u>	<u>10</u>
<u>Hard clay &amp; chalk</u>	<u>10</u>	<u>20</u>
<u>red sand</u>	<u>20</u>	<u>43</u>
<u>Black dirt</u>	<u>43</u>	<u>54</u>
<u>white sand</u>	<u>54</u>	<u>70</u>

WELL LOCATION:  
 sec. 15 T. 18 N. R. 6 E  
S W  
4 miles S.W. of Kilmichael  
 (distance) (direction) (nearest town)

WELL PURPOSE:  
 home,  irrigation,  municipal,  industrial

WELL COMPLETION DATA:

(1) diameter (inches) 2

(2) total depth (feet) 70

(3) static water level (feet) 56  below above top of ground.

(4) casing PVC, 65,  
 (material) (depth)  
2 if telescope see back.  
 (size)

(5) screen 5, 65  
 (length) (depth to top)  
1 1/4" 8 slot S.S.  
 (size) (material)

(6) pump 1 10  
 (HP) (yield gpm)  
5/100  
 (type power)

(7) electric log no  
 (yes or no)

(organization running log)

(8) how well bottom plugged Point

**CODED**


JUN 10 1971

DRILLERS REMARKS:

MISS. BD. OF  
 WATER COMM.

If well telescopes please sketch and show depths.

GROUND LEVEL

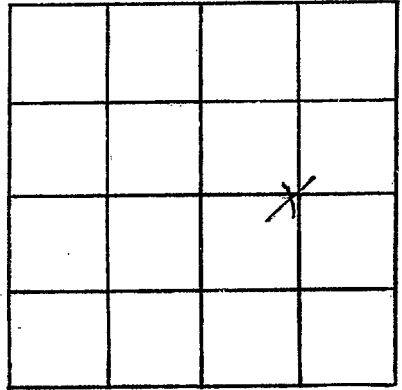

SECTION 15

Please indicate well location X.

ADDITIONAL INFORMATION

If more than one screen, show locations of each on sketch.