

Montgomery
J18
12-8-71

MISSISSIPPI
 BOARD OF WATER COMMISSIONERS
 416 North State Street
 Jackson, Mississippi 39201

FEB - 4 1972

CODED
CODED

WATER WELL DRILLERS LOG

12-8 1971
 date well completed

Thomas Sear
 firm name

Montgomery
 county well located

LANDOWNER: Mr. Harris

description of formations encountered

from

to

Kilmichael, Miss

white Chalk

0

18

Red sand & Chalk

18

28

Chalk

28

34

Course Sand

34

37

(mailing address)

WELL LOCATION:

sec. 25 T. 18 N. R. 6 E

3 1/2 miles SW of Kilmichael
 (distance) (direction) (nearest town)

WELL PURPOSE:

(home, irrigation, municipal, industrial)

WELL COMPLETION DATA:

(1) diameter (inches) 2
 (2) total depth (feet) 39
 (3) static water level (feet) 20 below top of ground.

(4) casing PVC 34
 (material) (depth)

2 if telescope see back.
 (size)

(5) screen 5 34
 (length) (depth to top)

2" PVC 105d
 (size) (material)

(6) pump 3/4 8
 (HP) (yield gpm)

elec.
 (type power)

(7) electric log NO
 (yes or no)

(organization running log)


(8) how well bottom plugged Point

DRILLERS REMARKS:

CODED

If well telescopes please sketch and show depths.

GROUND LEVEL

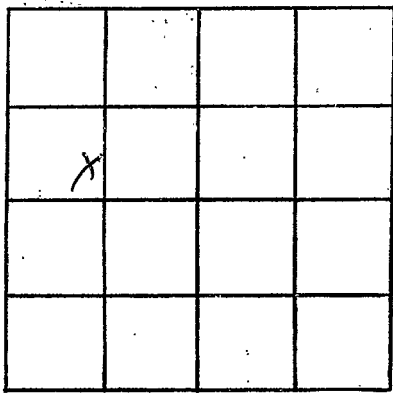

SECTION 25

Please indicate well location X.

ADDITIONAL INFORMATION

A series of horizontal lines for entering additional information.

If more than one screen, show locations of each on sketch.