

Montgomery  
J 19  
4-17-72

MISSISSIPPI  
 BOARD OF WATER COMMISSIONERS  
 416 North State Street  
 Jackson, Mississippi 39201

**CODED**

WATER WELL DRILLERS LOG

4-17 1972 Thomas & Son Montgomery  
 date well completed firm name county well located

LANDOWNER: <u>J. L. Cozzius</u> <u>Kilmichael, Miss.</u>	description of formations encountered	from	to
(mailing address)			
	<u>1. 10 Clay</u>	<u>0</u>	<u>15</u>
	<u>37Ks Hard Chalk</u>	<u>15</u>	<u>25</u>
	<u>&amp; Little Sand</u>		
	<u>Course Reddish Sand</u>	<u>25</u>	<u>40</u>

WELL LOCATION:  
 sec. 11 T. 19 S. R. 6 E.  
3 miles W of Kilmichael  
 (distance) (direction) (nearest town)

WELL PURPOSE:  
 home, irrigation, municipal, industrial

- WELL COMPLETION DATA:
- diameter (inches) 2
  - total depth (feet) 40
  - static water level (feet) 12  below above top of ground.
  - casing PVC, 35'  
 (material) (depth)  
2 if telescope see back.  
 (size)
  - screen 5', 35'  
 (length) (depth to top)  
2" 8.5/64 PVC  
 (size) (material)
  - pump 1/2 7  
 (HP) (yield gpm)  
Elec.  
 (type power)
  - electric log NO  
 (yes or no)
- (organization running log)
- (8) how well bottom plugged Point

**CODED**


JUL 5 1972

DRILLERS REMARKS:

MISS. BD. OF  
 WATER COM.

If well telescopes please  
sketch and show depths.

GROUND LEVEL

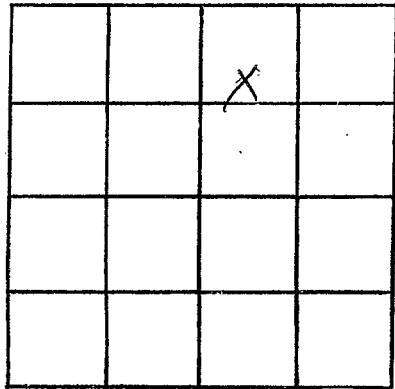

SECTION 11

Please indicate well location X.

ADDITIONAL INFORMATION

If more than one screen,  
show locations of each on sketch.