

Montgomery  
J 20  
4-18-72

MISSISSIPPI  
 BOARD OF WATER COMMISSIONERS  
 416 North State Street  
 Jackson, Mississippi 39201

**CODED**

WATER WELL DRILLERS LOG

4-18-72 date well completed      Thomas & Son firm name      Montgomery county well located

LANDOWNER: <u>W.L. Fox</u> <u>WYMONA, MISS.</u>	description of formations encountered	from	to
		0	15
(mailing address)	<u>Red CLAY</u>	15	50
	<u>Red SAND</u>	50	62
	<u>5TKS CHALK &amp; SAND</u>	62	68
	<u>Red SAND &amp; CHALK</u>	68	75
	<u>5TKS white SAND &amp; HARD CHALK</u>		

WELL LOCATION:  
 sec. 22 T 16 (N) R. 6 (E)  
5 miles S.W. of Kilmichael  
 (distance) (direction) (nearest town)

WELL PURPOSE:  
 (home, irrigation, municipal, industrial)

- WELL COMPLETION DATA:
- diameter (inches) 2
  - total depth (feet) 75
  - static water level (feet) 50 <sup>below</sup> above top of ground.
  - casing PVC 65  
 (material) (depth)  
2 if telescope see back.  
 (size)
  - screen 10 65  
 (length) (depth to top)  
1/4 slot S.S.  
 (size) (material)
  - pump 1 8  
 (HP) (yield gpm)  
Elec.  
 (type power)
  - electric log no  
 (yes or no)
  - (organization running log)
  - how well bottom plugged point


**CODED**

DRILLERS REMARKS:

APR 20 1972  
 MISSISSIPPI BOARD OF WATER COMMISSIONERS

If well telescopes please sketch and show depths.

GROUND LEVEL

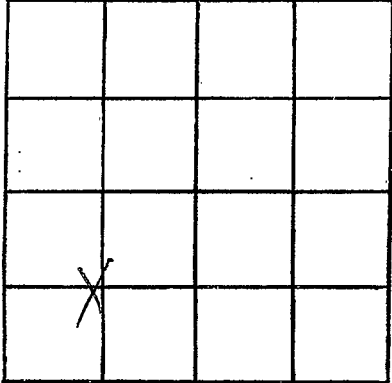

SECTION 22

Please indicate well location X.

ADDITIONAL INFORMATION

A series of horizontal lines for additional information.

If more than one screen, show locations of each on sketch.