

Montgomery
J 21
4-27-72

MISSISSIPPI
 BOARD OF WATER COMMISSIONERS
 416 North State Street
 Jackson, Mississippi 39201

CODED

WATER WELL DRILLERS LOG

4-27 1972 Thomas & Son Montgomery
 date well completed firm name county well located

LANDOWNER: <u>Ralph Collins</u> <u>MINONA, Miss.</u>	description of formations encountered	from	to
		0	20
(mailing address)	<u>Red Clay</u>	20	40
	<u>yellow CHALK</u>	40	127
	<u>Mostly Black dirt</u>		
	<u>w/ little streaks Fine SAND</u>		
	<u>Coarse white SAND</u>	127	137

WELL LOCATION:
 sec. 15 T. 18 N. R. 6 E
4 miles SW of Kilmichael
 (distance) (direction) (nearest town)

WELL PURPOSE:
 (home, irrigation, municipal, industrial)


- WELL COMPLETION DATA:
- (1) diameter (inches) 2
 - (2) total depth (feet) 137
 - (3) static water level (feet) 65 ^{below} above top of ground.
 - (4) casing PVC, 131
 (material) (depth)
2 if telescope see back.
 (size)
 - (5) screen 6, 131
 (length) (depth to top)
2, 8 slot PVC
 (size) (material)
 - (6) pump 1, 7
 (HP) (yield gpm)
Elec.
 (type power)
 - (7) electric log NO
 (yes or no)
 - (organization running log)
 - (8) how well bottom plugged Point

CODED

DRILLERS REMARKS:

If well telescopes please sketch and show depths.

GROUND LEVEL

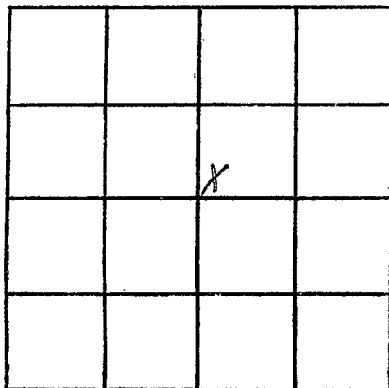

SECTION 15

Please indicate well location X.

ADDITIONAL INFORMATION

If more than one screen,
show locations of each on sketch.