

MISSISSIPPI DEPARTMENT OF NATURAL RESOURCES

Bureau of Land and Water Resources

Southport Mall

P.O. Box 10631

Jackson, Mississippi 39209

WATER WELL DRILLERS LOG

MONTGOMERY
J24
4-9-85

4-9 1985
date well completed

85 Thomas & Son
firm name

Montgomery Co
county well located

LANDOWNER: Bobby Delatt

description of formations encountered

from

to

Rt 2
Kiln, Miss
(mailing address)

Red Dirt	0	4
Red Sand	4	26
Yellow Sand	26	38
White C. Sand	38	85
Grey Chalk	85	180
White C. Sand	140	180

WELL LOCATION:

sec. 3 T. 18 N. R. 6 E. S. W.
5 miles W of Kiln, Miss
(distance) (direction) (nearest town)

WELL PURPOSE:

(home, irrigation, municipal, industrial)

WELL COMPLETION DATA:

- (1) diameter (inches) 2"
- (2) total depth (feet) 180'
- (3) static water level (feet) 54' below top of ground.
- (4) casing PVC, 180' (material) (depth)
2" (size) if telescope see back.
- (5) screen 10', 170' (length) (depth to top)
10" (size) PVC (material)
- (6) pump 1 (HP) 8 (yield gpm)
Electric (type power)
- (7) electric log NO (yes or no)
(organization running log)
- (8) how well bottom plugged Screen

RECEIVED


MAY 17 1985

Department of Natural Resources
Bureau of Land & Water Resources

DRILLERS REMARKS:

If well telescopes please sketch and show depths.

GROUND LEVEL

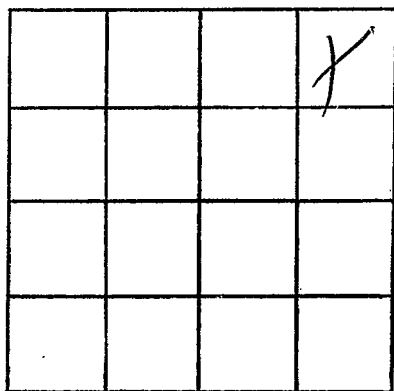

SECTION _____

Please indicate well location X.

ADDITIONAL INFORMATION

If more than one screen,
show locations of each on sketch.