

MONTGOMERY
 J 2000
 3/22/77

MISSISSIPPI
 BOARD OF WATER COMMISSIONERS
 416 North State Street
 15K Jackson, Mississippi 39201

WATER WELL DRILLERS LOG

3-22 1977 date well completed
 THOMAS & SON firm name
 Montgomery county well located

LANDOWNER: <u>John T. Seaworth</u>	Description of formations encountered	from	to
<u>WINONA, Miss</u>	<u>red clay</u> <u>red sand</u> <u>sand</u>	<u>0</u>	<u>10</u>
(mailing address)		<u>10</u>	<u>20</u>
WELL LOCATION:			
sec. <u>13</u> T <u>18</u> N R <u>5</u> E S W			
<u>3</u> miles <u>S</u> of <u>WINONA</u> (distance) (direction) (nearest town)			
WELL PURPOSE: (Home, irrigation, municipal, industrial)			
WELL COMPLETION DATA:			
(1) diameter (inches) <u>2</u>			
(2) total depth (feet) <u>56</u>			
(3) static water level (feet) <u>46</u> ^(below) _(above) top of ground.			
(4) casing <u>PVC</u> <u>51</u> (material) (depth)			
<u>2</u> (size) if telescope see back.			
(5) screen <u>5</u> <u>51</u> (length) (depth to top)			
<u>2"</u> <u>3 slot PVC</u> (size) (material)			
(6) pump <u>1</u> <u>8</u> (HP) (yield gpm)			
<u>elec.</u> (type power)			
(7) electric log <u>No</u> (yes or no)			
(organization running log)			
(8) how well bottom plugged <u>fair</u>			


DRILLERS REMARKS:

RECEIVED
 APR 1 1977

MISS. BD. OF WATER COMMISSIONERS

If well telescopes please sketch and show depths.

GROUND LEVEL

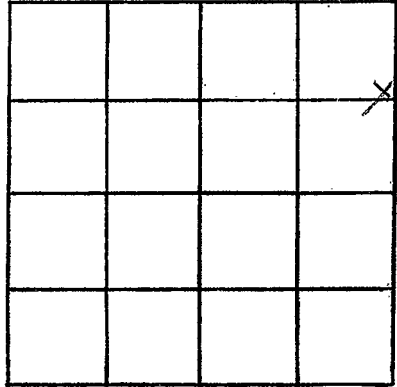

SECTION 13

Please indicate well location X.

ADDITIONAL INFORMATION

If more than one screen,
show locations of each on sketch.