

K 8

6-64

WATER WELL DRILLERS LOG

Date: June, 1964, Driller: Jack Morton Holmes County Holmes
 (Name)


(1) Owner of Land: Marion Williams
 (Name)
Kilmichael Moss
 (Address)
 (2) Location: NE 1/4, NW 1/4, Sec. 12 T18 R 7E
3 miles East of Kilmichael
 (distance) (direction) (Nearest Town)
 (3) Topography: Hilly
 (Hilly) (Flat) (Level)
 (4) Purpose of Well: Domestic
 (Domestic Irrigation, Municipal, Industrial, Other)

Description & Color of Materials Sand, Clay, Red Clay, Shell, etc.	Thick- ness Feet	Depth Feet
Red clay	10	10
pipe clay	15	25
↳ little sand	47	72
Black mud	38	110
Sand	20	130
Mud	10	140
Mud & Sand	11	157
Mud	72	228
Rock	3	226
↳ Sand & shale	42	268
Sand	22	290
Mud	155	445
Rock	3	448
Mud	104	552
Sand	37	589

Information upon completion of well:

(1) Diameter 2 inches.
 (2) Total Depth 589 feet.
 (3) Water Level 36 feet below top of ground.
 (4) Cased to 584, Size 2
 (5) Screen: Size 2, Length 15'
 (6) Were any formations sealed against pollution?
 _____ yes, _____ no.

If YES depth of formation _____
 Why _____
 Drillers Remarks: _____

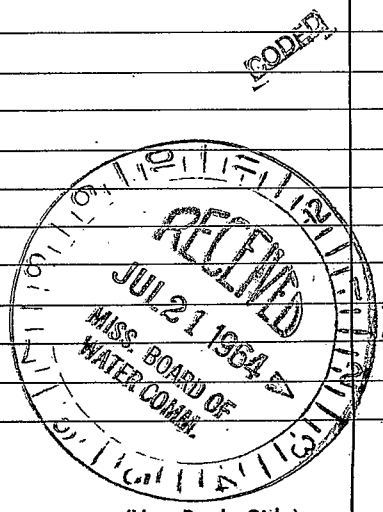

(Use Back Side)

Well No.

