

K14
6-66

WATER WELL DRILLERS LOG

CODED

Date: June, 1966, Driller: Jack Martin County Holman
(Name)

(1) Owner of Land: William Briston
(Name)
William Briston
(Address)

(2) Location: NW 1/4, SW 1/4, Sec. 11 T18 R7E
1/2 miles East, of B. Buckwalter
(distance) (direction) (Nearest Town)

(3) Topography: Flat
(Hilly) (Flat) (Level)

(4) Purpose of Well: Chicken Farm
(Domestic Irrigation
Municipal, Industrial, Other)

Description & Color of Materials Sand, Clay, Red Clay, Shell, etc.	Thick- ness Feet	Depth Feet
Clay	3	3
Sand	10	13
Mud	50	63
Sand	3	71
Mud	63	134
Sand	20	154
Sand (mud streaks)	27	181
Mud	74	255
Sand	20	275
Mud	15	290
Sand	26	316

Information upon completion of well:

(1) Diameter 4 inches. x 2"

(2) Total Depth 316 feet.

(3) Water Level 3 feet below top of ground.

(4) Cased to 301, Size 4" x 2"

(5) Screen: Size 3", Length 15'


(6) Were any formations sealed against pollution?
_____ yes, _____ no.

CODED

If YES depth of formation _____

Why _____

Drillers Remarks: _____

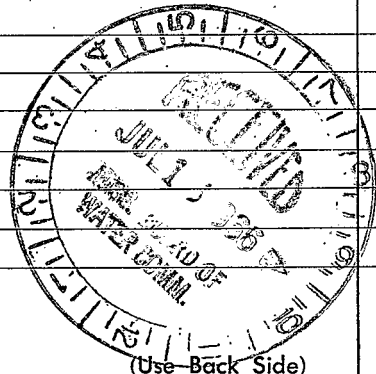

Well No.

