

MONTGOMERY
K 15
9-70

MISSISSIPPI
 BOARD OF WATER COMMISSIONERS
 416 North State Street
 Jackson, Mississippi 39201

CODED

WATER WELL DRILLERS LOG

Sept. 1970 Thomas & Son Montgomery
 date well completed firm name county well located

LANDOWNER: Mrs. Bridges
Kilmichael, Miss
Hwy 82 E.
 (mailing address)

WELL LOCATION:
 sec. 3 T-18 S R-7 E Chalk
2 miles E of Kilmichael
 (distance) (direction) (nearest town)

WELL PURPOSE:
 (home, irrigation, municipal, industrial)

- WELL COMPLETION DATA:
- (1) diameter (inches) 2
 - (2) total depth (feet) 388
 - (3) static water level (feet) 12 below top of ground.
 - (4) casing Galv. 315
 (material) (depth)
2 if telescope see back.
 (size)
 - (5) screen open
 (length) (depth to top)
 (size) (material)
 - (6) pump 3/4 8
 (HP) (yield gpm)
Elec.
 (type power)
 - (7) electric log NO
 (yes or no)
 (organization running log)
 - (8) how well bottom plugged

description of formations encountered	from	to
Dirt	10	15
Chalk	15	22
Course Red Sand	22	27
Sticky Chalk	27	44
Black & Blue Chalk	44	75
Chalk & Sand Fine	75	137
Hard	137	138
Sand w/ sticky Chalk	138	169
Grey Chalk	168	224
Hard Rock	224	225
Blue Chalk with	225	336
Rock at 275 & 315		
fine Greenish Sand	336	375
1 1/2" Real Hard Rock	375	376
fine Greenish Sand	376	388

CODED


OCT 14 1970

MISS. Bd. of
 WATER COMMISSIONERS

DRILLERS REMARKS:

If well telescopes please sketch and show depths.

GROUND LEVEL

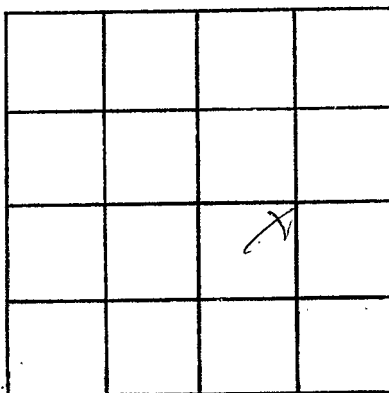

SECTION 5

Please indicate well location X.

ADDITIONAL INFORMATION

If more than one screen,
show locations of each on sketch.