

**MONTGOMERY**  
 K16  
 3-5-71

MISSISSIPPI  
 BOARD OF WATER COMMISSIONERS  
 416 North State Street  
 Jackson, Mississippi 39201  
**WATER WELL DRILLERS LOG**

**CODED**

3-5-71 date well completed 1971 Thomast Son firm name Montgomery county well located

LANDOWNER: Frank Grey  
Kilmichael, Miss.  
 (mailing address)  
 WELL LOCATION:  
 sec. 34T 19N R. 7E  
3 1/2 miles SE of Kilmichael  
 (distance) (direction) (nearest town)

description of formations encountered	from	to
<u>Red Clay</u>	<u>0</u>	<u>7</u>
<u>SAND ROCK</u>	<u>7</u>	<u>8</u>
<u>Red Sand</u>	<u>8</u>	<u>30</u>
<u>SAND ROCK &amp; yellow Sand</u>	<u>30</u>	<u>38</u>
<u>Mostly Chalk Little SAND STRS.</u>	<u>38</u>	<u>52</u>
<u>Black Dirt</u>	<u>52</u>	<u>85</u>
<u>SAND</u>	<u>85</u>	<u>95</u>

WELL PURPOSE:  
 (home, irrigation, municipal, industrial)

WELL COMPLETION DATA:  
 (1) diameter (inches) 2  
 (2) total depth (feet) 95  
 (3) static water level (feet) 65 below above top of ground.  
 (4) casing PVC 90  
 (material) (depth)  
2 If telescope see back.  
 (size)  
 (5) screen 5 90  
 (length) (depth to top)  
1 1/4 slot S.S.  
 (size) (material)  
 (6) pump 1 3  
 (HP) (yield gpm)  
Elec.  
 (type power)  
 (7) electric log NO  
 (yes or no)  
 (organization running log)  
 (8) how well bottom plugged point

**CODED**


MAR 23 1971

MISS. BD. OF  
 WATER COM.

DRILLERS REMARKS:

If well telescopes please sketch and show depths.

GROUND LEVEL

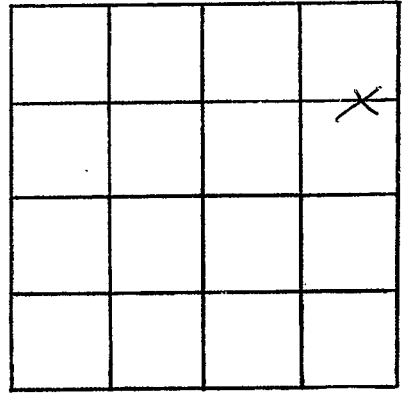

SECTION 34

Please indicate well location X.

ADDITIONAL INFORMATION

If more than one screen, show locations of each on sketch.