

MONTGOMERY
K18
9-15-71

MISSISSIPPI
 BOARD OF WATER COMMISSIONERS
 416 North State Street
 Jackson, Mississippi 39201

WATER WELL DRILLERS LOG

CODED

9-15 date well completed 1971 THOMAS + SON firm name Montgomery county well located

LANDOWNER: Bobby Greenlee
 Kilmichael, Miss.

(mailing address)

WELL LOCATION:

sec. 36 T. 18 N. R. 7 E
 4 1/2 miles SE of Kilmichael
 (distance) (direction) (nearest town)

WELL PURPOSE:

(home, irrigation, municipal, industrial)

WELL COMPLETION DATA:

- (1) diameter (inches) 2
- (2) total depth (feet) 231
- (3) static water level (feet) 65 (below/above top of ground)
- (4) casing Galv. 152
 (material) (depth)
2 if telescope see back.
 (size)
- (5) screen open
 (length) (depth to top)
 (size) (material)
- (6) pump 1 8
 (HP) (yield gpm)
Elec.
 (type power)
- (7) electric log NO
 (yes or no)
 (organization running log)
- (8) how well bottom plugged open

description of formations encountered	from	to
Red Clay	0	12
Black Dirt	12	31
Course Sand	31	35
Gray Blue Chalk	35	63
Rock	63	77
Black Dirt	77	88
Blue Black + Grey Dirt	88	157
Sand + silt	157	159
STRS OF GREEN SAND + HARD DIRT	159	231
		159
		72

CODED


OCT 20 1971

MISS. DE. OF
 WATER COMMISSIONERS

DRILLERS REMARKS:

If well telescopes please sketch and show depths.

GROUND LEVEL

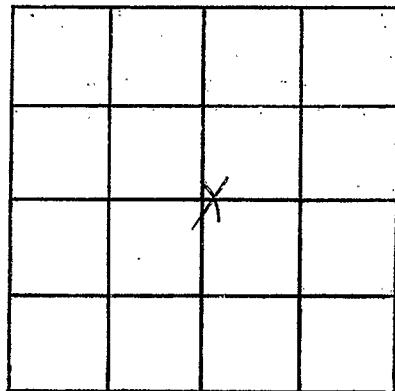

SECTION 36

Please indicate well location X.

ADDITIONAL INFORMATION

If more than one screen, show locations of each on sketch.