

**MONTGOMERY**  
**K 20**  
**6-73**

MISSISSIPPI  
 BOARD OF WATER COMMISSIONERS  
 416 North State Street  
 Jackson, Mississippi 39201

**CODED**

**WATER WELL DRILLERS LOG**

date well completed June 19 73 firm name Jack Martin Well Services county well located Montgomery

LANDOWNER: <u>John English</u>	description of formations encountered	from	to
<u>Kilmichael, Miss.</u> (mailing address)	<u>Sand</u>	<u>0</u>	<u>37</u>
WELL LOCATION: sec <u>26 T 18 N R 7 E</u> <u>4 1/4</u> miles <u>SE</u> of <u>Kilmichael</u> (distance) (direction) (nearest town)	<u>Mud</u>	<u>37</u>	<u>42</u>
WELL PURPOSE: <u>Home</u> (home, irrigation, municipal, industrial)	<u>Sand</u>	<u>42</u>	<u>54</u>
WELL COMPLETION DATA: (1) diameter (inches) <u>2 in</u> (2) total depth (feet) <u>88 ft</u> (3) static water level (feet) <u>65</u> below above top of ground. (4) casing <u>plastic</u> , <u>80 ft</u> (material) (depth) <u>2 in</u> if telescope see back. (size) (5) screen <u>8 ft</u> , <u>80 ft</u> (length) (depth to top) <u>2 in</u> , <u>plastic</u> (size) (material) (6) pump <u>1</u> , <u>86</u> (HP) (yield gpm) <u>Elec</u> (type power) (7) electric log (yes or no)  (organization running log) (8) how well bottom plugged <u>cap</u>	<u>Mud</u>	<u>54</u>	<u>67</u>
DRILLERS REMARKS: <u>On Hwy</u> <u>413</u>	<u>Sand</u>	<u>67</u>	<u>88</u>


**CODED**

JUN 30 1973

MISS. DIV. OF  
 WATER CONTROL

If well telescopes please sketch and show depths.

GROUND LEVEL

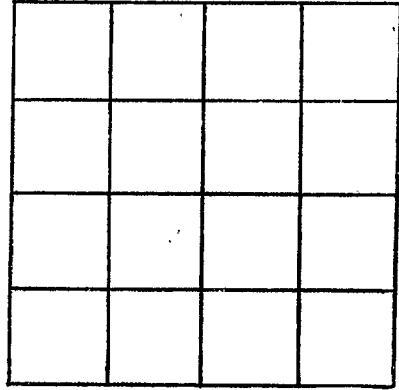

SECTION \_\_\_\_\_

Please indicate well location X.

ADDITIONAL INFORMATION

If more than one screen, show locations of each on sketch.