

**MONTGOMERY**  
 K 21  
 6-73

MISSISSIPPI  
 BOARD OF WATER COMMISSIONERS  
 416 North State Street  
 Jackson, Mississippi 39201  
**WATER WELL DRILLERS LOG**

**CODED**


June 19 73 JackMaster Well Service Montgomery  
 date well completed firm name county well located

LANDOWNER: James Dennis	description of formations encountered	from	to
Kilmichael Miss (mailing address)	Clay	0	10
WELL LOCATION: sec. 26 T 18 S R 7 E	Sand	10	68
4 miles SE of Kilmichael (distance) (direction) (nearest town)	Sand + mud	68	80
WELL PURPOSE: home (home, irrigation, municipal, industrial)	Sand	80	117
WELL COMPLETION DATA:	Mud <b>CODED</b>	117	120
(1) diameter (inches) 2 in	CODED	120	130
(2) total depth (feet) 130			
(3) static water level (feet) 95 below top of ground.			
(4) casing steel, 125 (material) (depth) 2" (size) if telescope see back.			
(5) screen 5 (length), 125 (depth to top) 2 in (size), stainless steel (material)			
(6) pump 1 (HP), 3 (yield gpm) Elec. (type power)			
(7) electric log (yes or no)			
(8) how well bottom plugged cap (organization running log)			
DRILLERS REMARKS: On Hwy 413			

JUN 30 1973

If well telescopes please sketch and show depths.

GROUND LEVEL

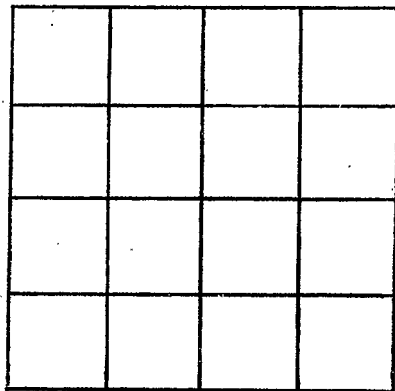

SECTION \_\_\_\_\_

Please indicate well location X.

ADDITIONAL INFORMATION

If more than one screen, show locations of each on sketch.