

MONTGOMERY

K 2000

3-29-78

MISSISSIPPI BOARD OF WATER COMMISSIONERS  
416 North State Street  
Jackson, Mississippi 39201

WATER WELL DRILLERS LOG

3-29 1978  
date well completed

Thomas & Son  
firm name

Montgomery  
county well located

LANDOWNER: W. A. Austin Jr.  
K. Michael, Miss.

(mailing address)

WELL LOCATION:

sec. 36 T 18 N S R 7 E  
4 miles 5 E of Kilmichael  
(distance) (direction) (nearest town)

WELL PURPOSE:

(home) irrigation, municipal, industrial

WELL COMPLETION DATA:

- (1) diameter (inches) 2
- (2) total depth (feet) 630
- (3) static water level (feet) 119 <sup>below</sup> top of ground.
- (4) casing 538 PVC  
(material) (depth)  
2 If telescope see back.  
(size)
- (5) screen open  
(length) (depth to top)  
(size) (material)
- (6) pump 3 H.P. Air 15  
(HP) (yield gpm)  
elec.  
(type power)
- (7) electric log no  
(yes or no)
- (organization running log)
- (8) how well bottom plugged: open

description of formations encountered	from	to
Dirt	0	4
Red Clay	4	20
5th SAND & CHALK	20	45
BLACK DIRT	45	90
SAND	90	98
Blue CHALK	98	140
Little Rock	140	
Grey-blue Black Dirt	140	238
Fine silt & CHALK	238	305
BLACK DIRT	305	330
Fine SAND	330	355
Grey & Blue CHALK	355	420
STKs Light & CHALK	420	480
SAND white	480	484
BLACK DIRT	484	510
Fine SAND & CHALK	510	524
HARD BLACK DIRT	524	540
Green SAND	540	630
with STKs CHALK		


RECEIVED  
APR - 3 1978

DRILLERS REMARKS:

MISS. BD. OF WATER COMM.

If well telescopes please sketch and show depths.

GROUND LEVEL

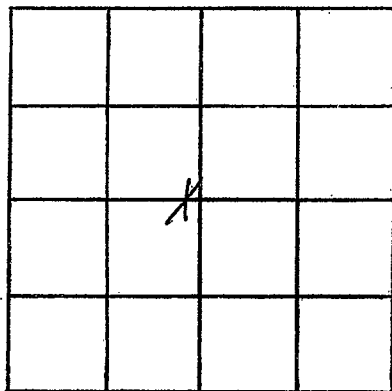

SECTION 36

Please indicate well location X.

ADDITIONAL INFORMATION

If more than one screen, show locations of each on sketch.