

Montgomery
K 2001

MISSISSIPPI
BOARD OF WATER COMMISSIONERS
416 North State Street
Jackson, Mississippi 39201

4/24/81

WATER WELL DRILLERS LOG

4-2-4 1981

Thomas
firm name

Montgomery
county well located

LANDOWNER: Ernest Anglin

description of formations encountered

from to

Rt 2

Dirt

0 8

Kilmichael, MS
(mailing address)

SAND

8 30

Grey CHALK

30 140

SAND & CHALK 5050

140 190

WELL LOCATION:

Dark Grey CHALK 190 230

sec 27 T 19 N R 7 E S W

CHALK & silty SAND 230 290

3 miles SE of Kilmichael
(distance) (direction) (nearest town)

Hard CHALK 290 298

Fine Grey Creep 298 300

WELL PURPOSE: Home
(home, irrigation, municipal, industrial)

SAND w/ some shells 423

CHALK

WELL COMPLETION DATA:

(1) diameter (inches) 2

(2) total depth (feet) 423

(3) static water level (feet) 15 (below above top of ground)

(4) casing PVC, 292
(material) (depth)

2 if telescope see back.
(size)

(5) screen Open
(length) (depth to top)

(size) (material)


(6) pump 1/2 8
(HP) (yield gpm)

Electric
(type power)

(7) electric log NO
(yes or no)

(organization running log)


(8) how well bottom plugged open

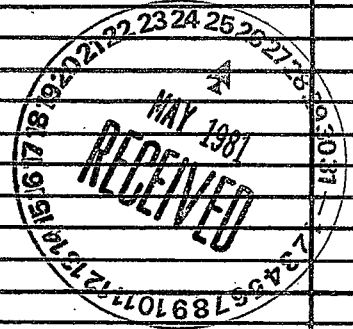

DRILLERS REMARKS:

If well telescopes please sketch and show depths.

GROUND LEVEL

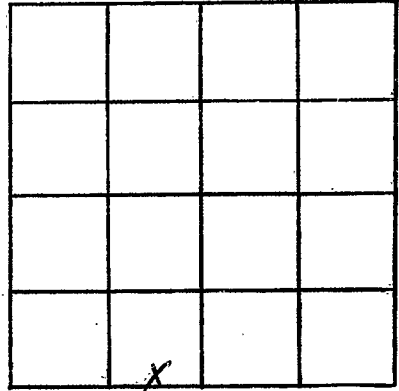

SECTION 27

Please indicate well location X.

ADDITIONAL INFORMATION

If more than one screen,
show locations of each on sketch.