

Montgomery
K 2003
8-14-81

MISSISSIPPI
BOARD OF WATER COMMISSIONERS
416 North State Street
Jackson, Mississippi 39201

WATER WELL DRILLERS LOG

8-14 1981 date well completed
Thomas firm name
Montgomery county well located

LANDOWNER: Y Denny Green	description of formations encountered	from	to
Popular Creek.			
(mailing address)	Red clay	0	19
	Red sand	19	70
	Grey CHALK	70	80
	SHLS CHALK + SAND	80	86
	SAND	86	102

WELL LOCATION:
sec. 31 T. 19 N. R. 7 E
4 miles SW of Kilmichael
(distance) (direction) (nearest town)

WELL PURPOSE:
(home, irrigation, municipal, industrial)

- WELL COMPLETION DATA:
- (1) diameter (inches) 4
 - (2) total depth (feet) 102
 - (3) static water level (feet) 50 below top of ground.
 - (4) casing PVC 82 (material) (depth)
4 (size) If telescope see back.
 - (5) screen 20 82 (length) (depth to top)
4 10 slot PVC (size) (material)
 - (6) pump 1/2 12 (HP) (yield gpm)
Elec (type power)
 - (7) electric log No (yes or no)

(organization running log)
(8) how well bottom plugged POINT

DRILLERS REMARKS:


DEPT. OF NATURAL RESOURCES
BUREAU OF LAND & WATER RESOURCES

OCT - 9 1981

RECEIVED

If well telescopes please sketch and show depths.

GROUND LEVEL

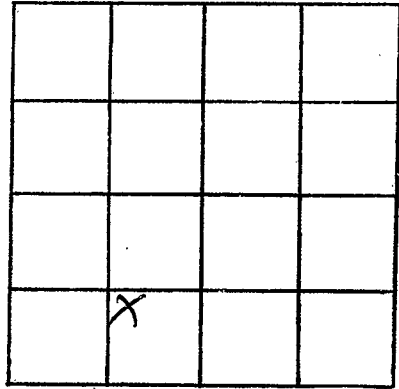

SECTION 31

Please indicate well location X.

ADDITIONAL INFORMATION

If more than one screen, show locations of each on sketch.