

Montgomery
K 2004
7-29-81

MISSISSIPPI
BOARD OF WATER COMMISSIONERS
416 North State Street
Jackson, Mississippi 39201

WATER WELL DRILLERS LOG

7-29-81 date well completed Thomas firm name Montgomery county well located

LANDOWNER: Minnie Jones
Kilmichael MS.
(mailing address)

WELL LOCATION:
sec 27 T 14 N R 7 E
2 1/2 miles SE of Kilmichael
(distance) (direction) (nearest town)

WELL PURPOSE:
(home, irrigation, municipal, industrial)

- WELL COMPLETION DATA:
- (1) diameter (inches) 2
 - (2) total depth (feet) 105
 - (3) static water level (feet) 105 below top of ground.
 - (4) casing PVC 100
(material) (depth)
 - 2 if telescope see back.
(size)
 - (5) screen 5 100
(length) (depth to top)
 - 2" 105 ft PVC
(size) (material)
 - (6) pump 3/4 6
(HP) (yield gpm)
 - elec.
(type power)
 - (7) electric log NO
(yes or no)

(organization running log)
(8) how well bottom plugged Point

DRILLERS REMARKS:


description of formations encountered	from	to
SAND	0	56
BLACK DIRT	56	63
FINE SAND & CHALK	63	80
COURSE SAND	80	105

DEPT OF NATURAL RESOURCES
BUREAU OF LAND & WATER RESOURCES

OCT - 9 1981
RECEIVED

If well telescopes please sketch and show depths.

GROUND LEVEL

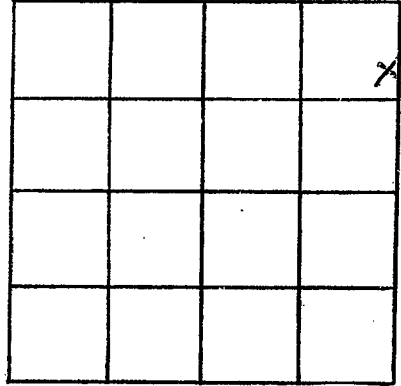

SECTION 27

Please indicate well location X.

ADDITIONAL INFORMATION

If more than one screen, show locations of each on sketch.