

MISSISSIPPI DEPARTMENT OF NATURAL RESOURCES

Bureau of Land and Water Resources

Southport Mall

P.O. Box 10631

Jackson, Mississippi 39209

WATER WELL DRILLERS LOG

Montgomery
OK
2005

1-31 1984 Thomas Isell Montgomery CO
date well completed firm name county well located

LANDOWNER: John P. Davis

RT-1

Stewart Miss
(mailing address)

WELL LOCATION:

sec. 29 T. 18 N. R. 7 E. W. S. W.
2 miles S.E. of St. Michel
(distance) (direction) (nearest town)

WELL PURPOSE:

(home) Irrigation, municipal, industrial

WELL COMPLETION DATA:

- (1) diameter (inches) 2"
- (2) total depth (feet) 168'
- (3) static water level (feet) 38' below above top of ground.
- (4) casing PVC, 168'
(material) (depth)
2" if telescope see back.
(size)
- (5) screen 10', 158'
(length) (depth to top)
2", PVC
(size) (material)
- (6) pump 1 (HP) 3 (yield gpm)
Electric
(type power)
- (7) electric log No
(yes or no)

(organization running log)

(8) how well bottom plugged Screen

DRILLERS REMARKS:


description of formations encountered	from	to
<u>Red dirt</u>	<u>0</u>	<u>8</u>
<u>Red sand</u>	<u>8</u>	<u>44</u>
<u>Gray chalk</u>	<u>44</u>	<u>90</u>
<u>Fine Gray sand</u>	<u>90</u>	<u>140</u>
<u>Coarse white sand</u>	<u>140</u>	<u>168</u>

Deep 168'

DEPT. OF NATURAL RESOURCES
BUREAU OF LAND & WATER RESOURCES
FEB - 8 1984
RECEIVED

If well telescopes please sketch and show depths.

GROUND LEVEL

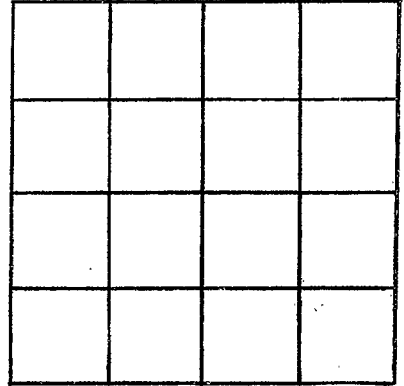

SECTION _____

Please indicate well location X.

ADDITIONAL INFORMATION

If more than one screen,
show locations of each on sketch.